




ON 15

REVISIONS:	NO.	DATE
	1	10/27/2015
	2	10/27/2015
	3	
	4	
	5	

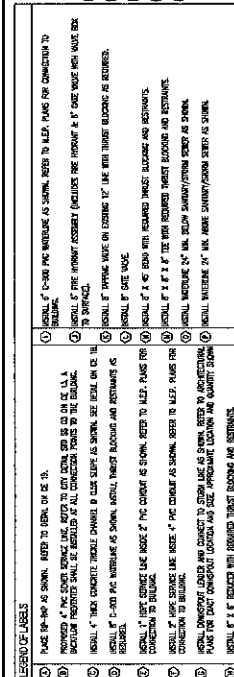

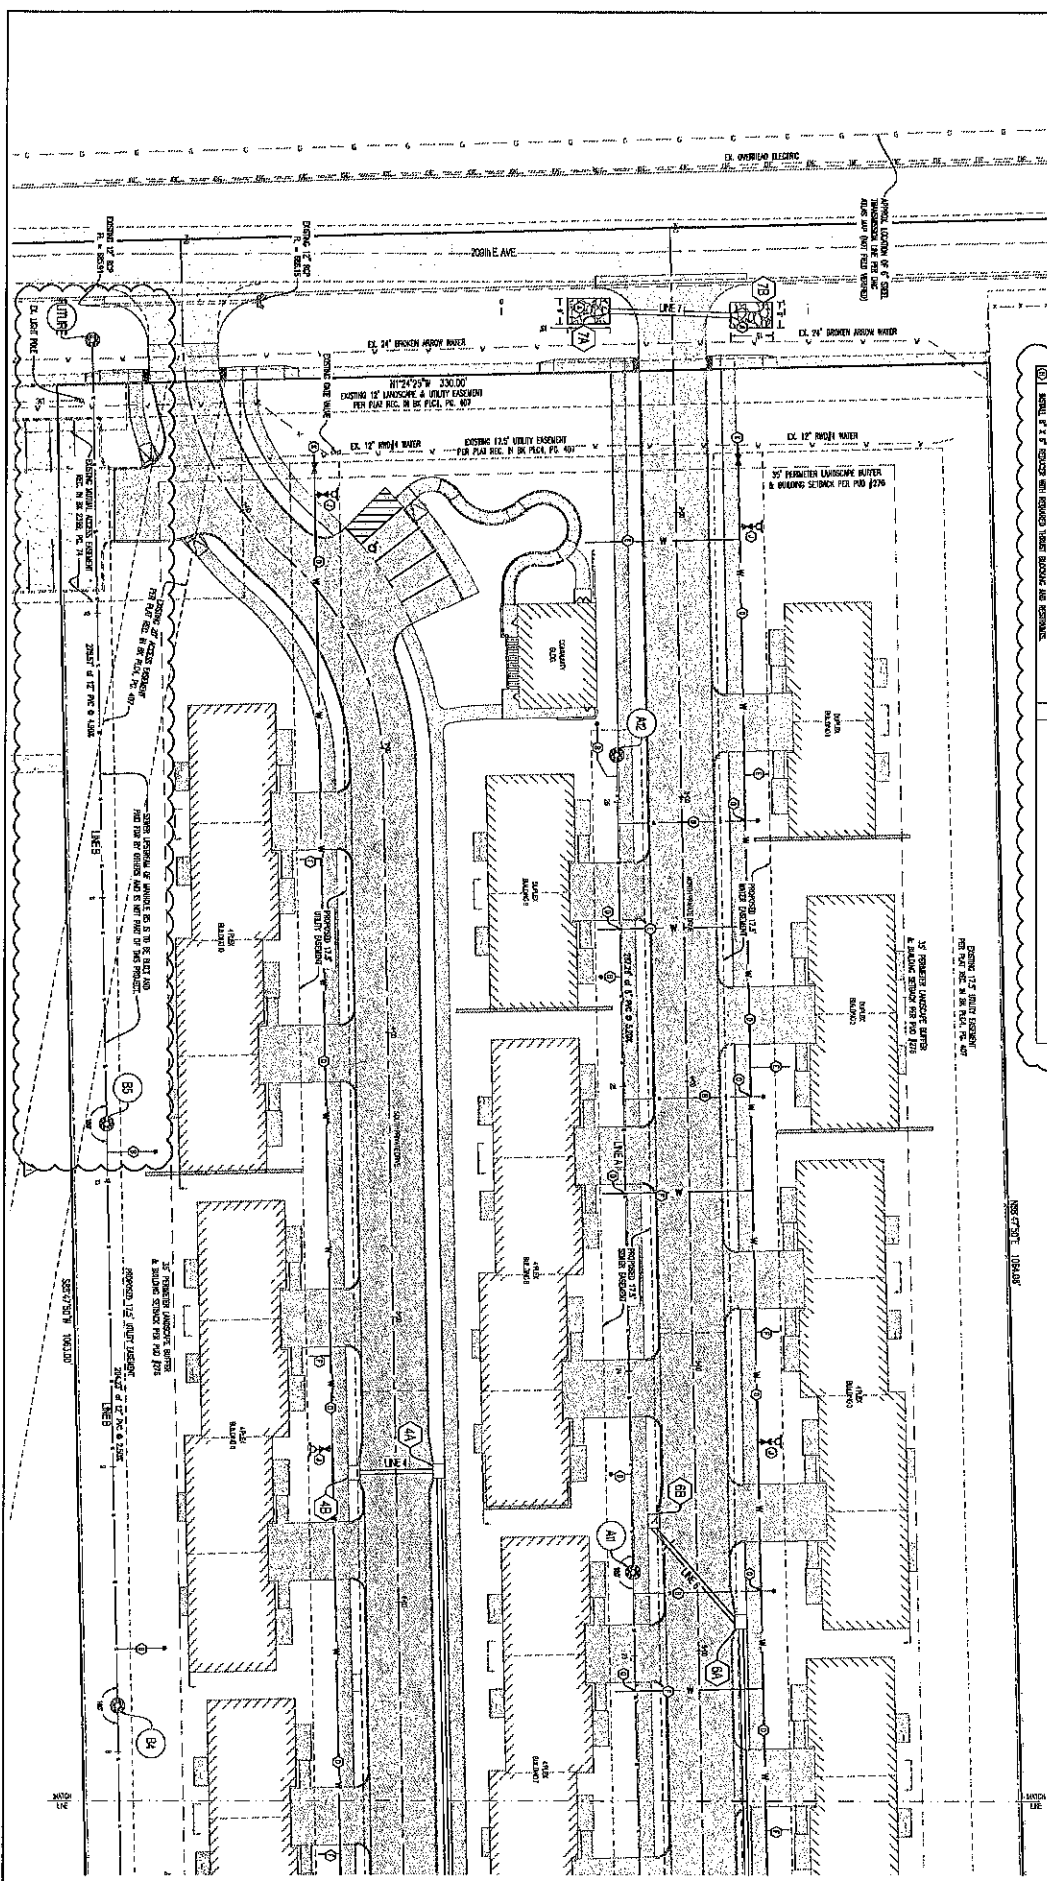

1. 1/2\"/>

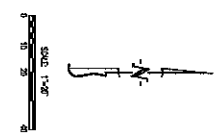

- GENERAL NOTES
1. ALL UTILITIES SHOWN ARE BASED ON RECORD DRAWINGS AND FIELD SURVEY. THE ENGINEER HAS CONDUCTED VISUAL INSPECTIONS OF THE EXISTING UTILITIES AND HAS FOUND THEM TO BE IN ACCORDANCE WITH THE RECORD DRAWINGS.
 2. THE UTILITIES SHOWN ARE BASED ON THE RECORD DRAWINGS AND FIELD SURVEY. THE ENGINEER HAS CONDUCTED VISUAL INSPECTIONS OF THE EXISTING UTILITIES AND HAS FOUND THEM TO BE IN ACCORDANCE WITH THE RECORD DRAWINGS.
 3. THE UTILITIES SHOWN ARE BASED ON THE RECORD DRAWINGS AND FIELD SURVEY. THE ENGINEER HAS CONDUCTED VISUAL INSPECTIONS OF THE EXISTING UTILITIES AND HAS FOUND THEM TO BE IN ACCORDANCE WITH THE RECORD DRAWINGS.
 4. THE UTILITIES SHOWN ARE BASED ON THE RECORD DRAWINGS AND FIELD SURVEY. THE ENGINEER HAS CONDUCTED VISUAL INSPECTIONS OF THE EXISTING UTILITIES AND HAS FOUND THEM TO BE IN ACCORDANCE WITH THE RECORD DRAWINGS.

tabbies®


EXHIBIT

B

TIMBER RIDGE COTTAGES LOCATED IN SECTION 8, TOWNSHIP 18 NORTH, RANGE 15 EAST BROKEN ARROW, WAGONER COUNTY, OKLAHOMA		OWNER DRIVE DEVELOPMENT, LLC 10001 LINDSEY MOORE, OK 73160	PREPARED BY CROCKETT ENGINEERING & SURVEYING, INC. 1000 N. 10TH ST., SUITE 100 OKLAHOMA CITY, OK 73106 www.crockettengineering.com Created: Engineering Documents, LLC Updated: Engineering Documents, LLC Printed: 10/10/2010	REVISIONS <table border="1"> <tr> <th>NO.</th> <th>DATE</th> <th>DESCRIPTION</th> </tr> <tr> <td>1</td> <td>10/10/2010</td> <td>ISSUED FOR PERMIT</td> </tr> </table>	NO.	DATE	DESCRIPTION	1	10/10/2010	ISSUED FOR PERMIT
NO.	DATE	DESCRIPTION								
1	10/10/2010	ISSUED FOR PERMIT								
DESIGNED BY DRAWN BY CHECKED BY DATE 10/10/2010	PROJECT NO. 10001	SHEET CE 8	NO. OF SHEETS 10							

COLLECTIONS	
LOADS	
DEAD	120 PSF
LIVE	40 PSF
WIND	150 MPH
SEISMIC	0.15g
SOIL	1.5

COLLECTIONS	
LOADS	
DEAD	120 PSF
LIVE	40 PSF
WIND	150 MPH
SEISMIC	0.15g
SOIL	1.5

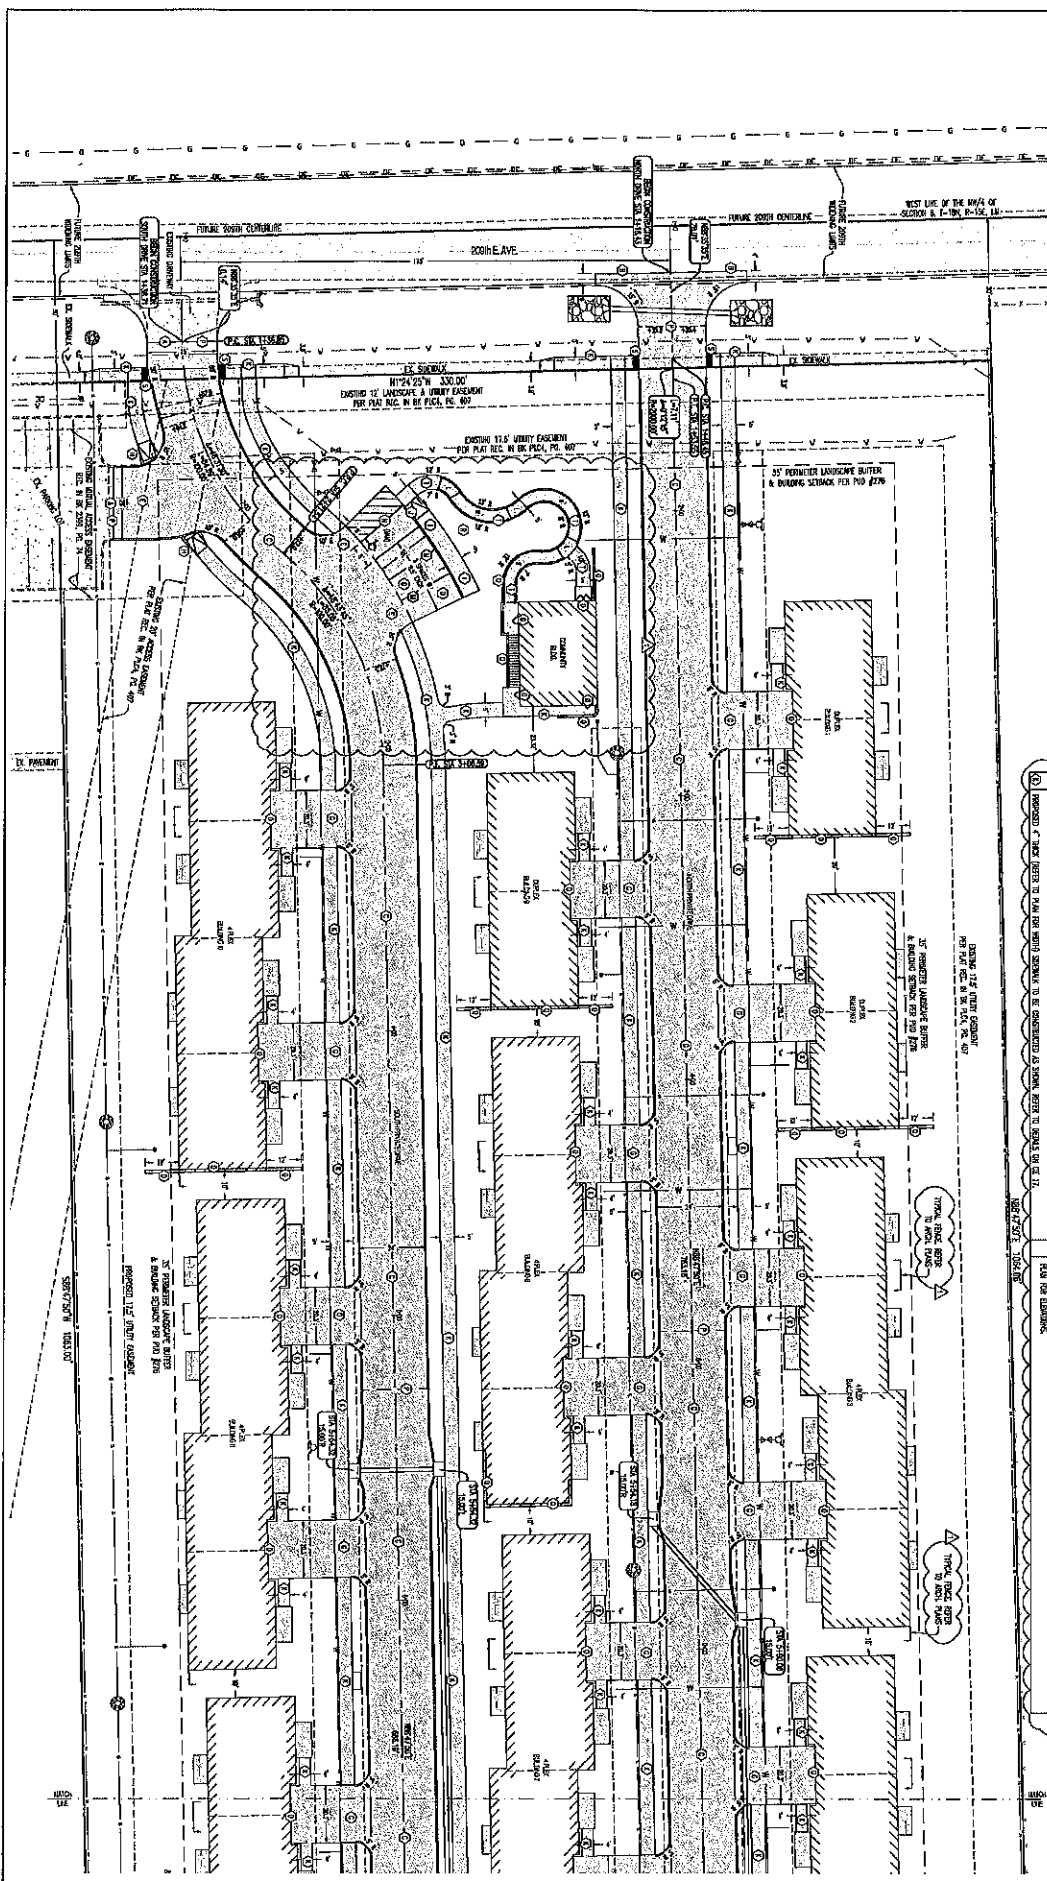

- LEGEND OF SYMBOLS**
- 1. SHOWN EXISTING CONCRETE FOUNDATION, REINFORCED CONCRETE IN 12\"/>



