


Checklist-Pine Valley Reserve

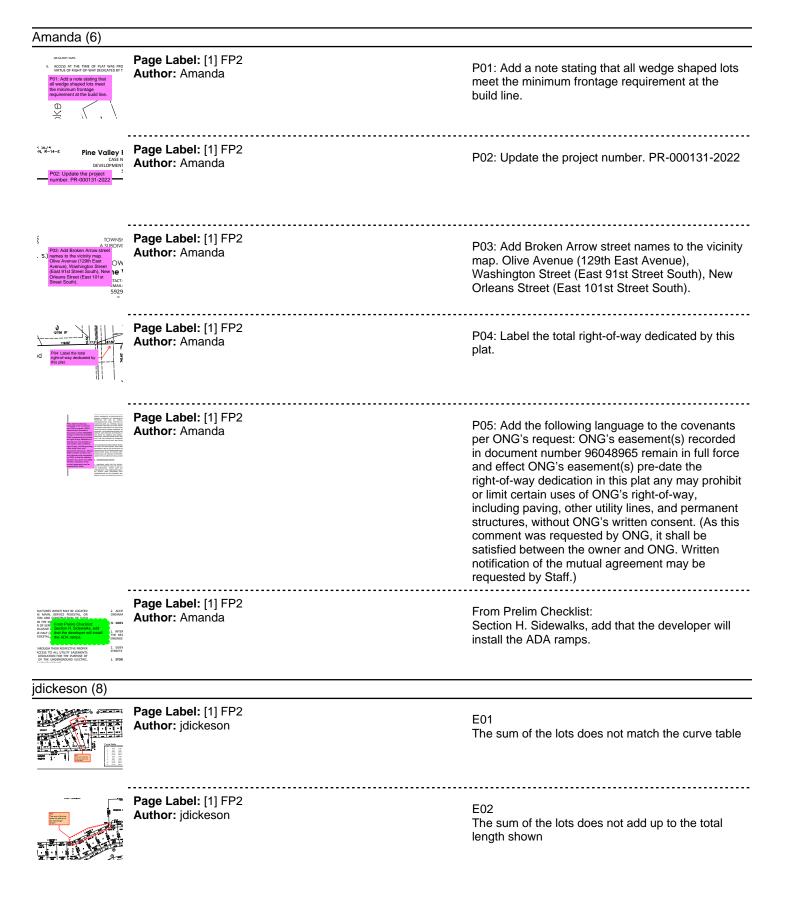

	Page Label: [1] FP2 Author: jdickeson	E03 The sum of the lots does not match the curve table
	Page Label: [1] FP2 Author: jdickeson	E04 Add the FEMA firm panel number, the effective date, and that the project is in zone x
ma na ana ana ana ana ana ana ana ana an	Page Label: [1] FP2 Author: jdickeson	E08 Substitute the city with the HOA
<text><text><text><text><text></text></text></text></text></text>	Page Label: [1] FP2 Author: jdickeson	E09 Designating reserve C as a utility easement will exclude any structures from being built in it
the state of a state of a state of the	Page Label: [1] FP2 Author: jdickeson	E10 Identify Reserve F on the plat
	Page Label: [1] FP2 Author: jdickeson	E11 Add to section C title "private storm sewer" Add a note All storm sewer in the development is private and will be maintained by the HOA and the residents of the subdivision. The city has the right to repair or replace any damaged facilities and bill the HOA or place a lien on all lots.
jmcelhenney (3)		
	Page Label: [1] FP2 Author: jmcelhenney	The conditional final plat is approved subject to the rights of way and easements and reserve areas, and their uses and restrictions described in the covenants, agreeing with the NET'd engineering plans. Also, surface drainage covenants are not enforced by the City, and Reserve A is to function as a utility easement, as noted.
 A set of the set of	Page Label: [1] FP2 Author: jmcelhenney	Reserve Area A is also for use as a utility easement.
	Page Label: [1] FP2 Author: jmcelhenney	Surface drainage covenants are not enforced by the City.

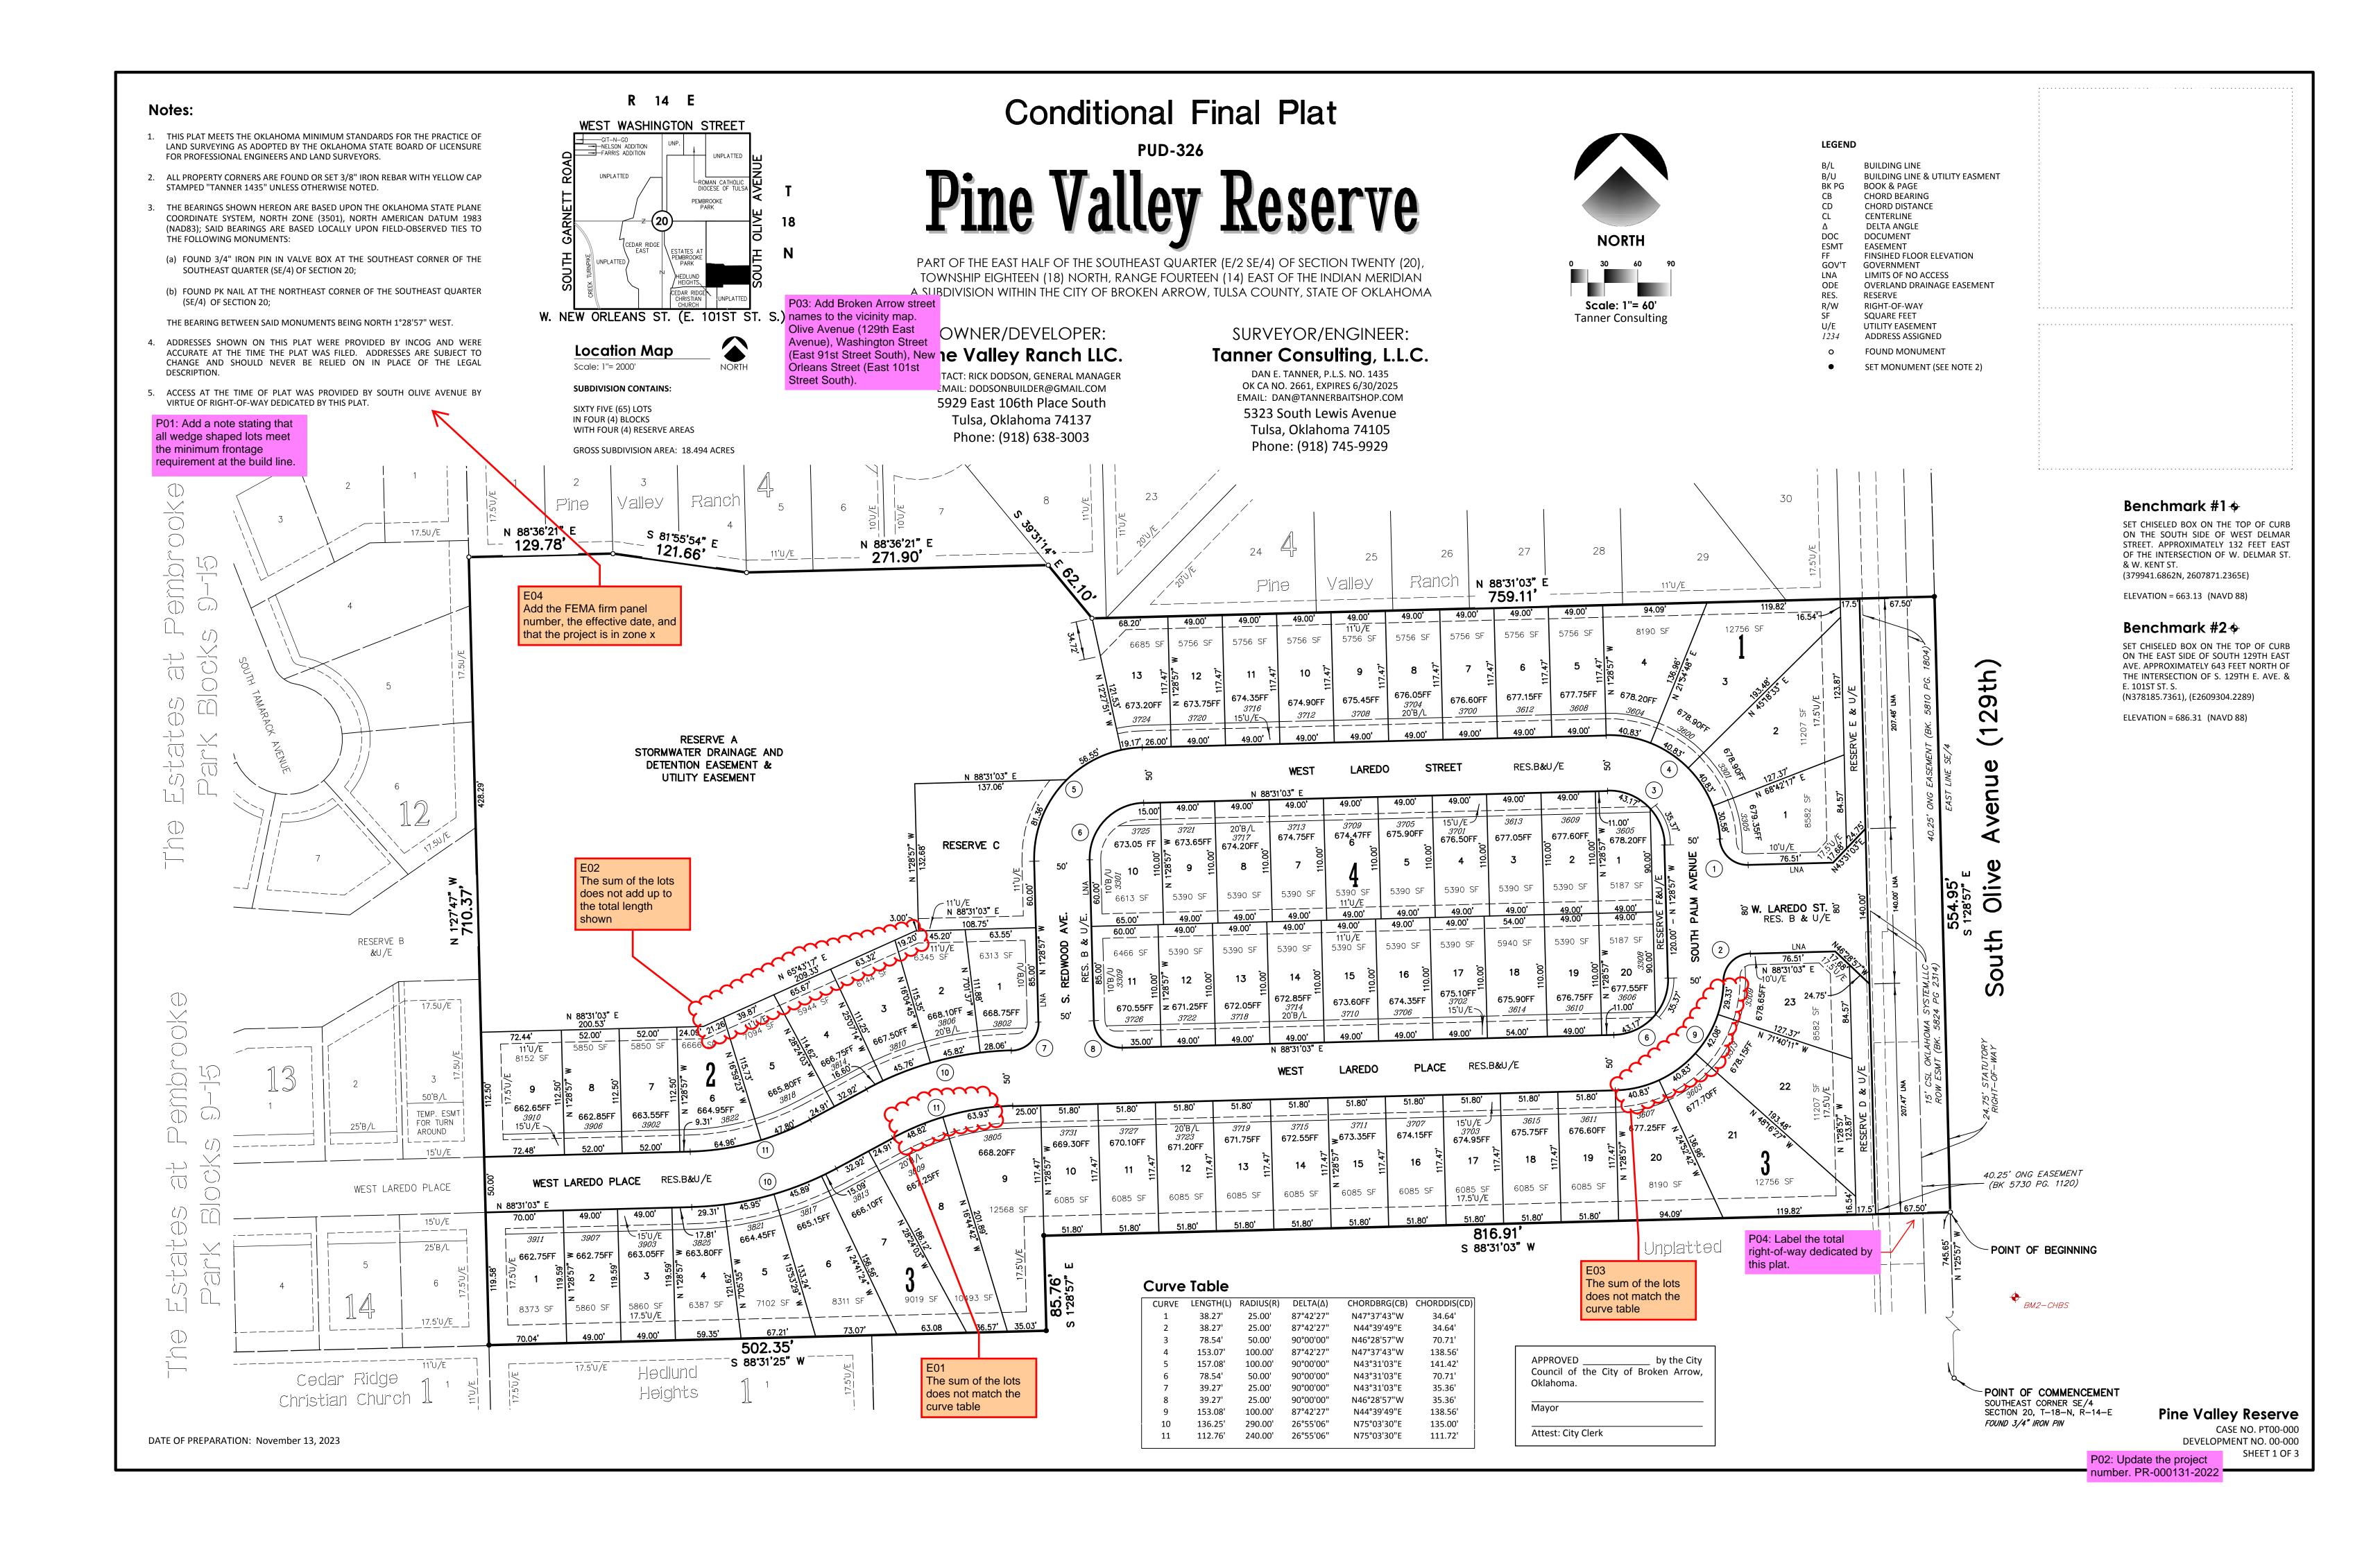

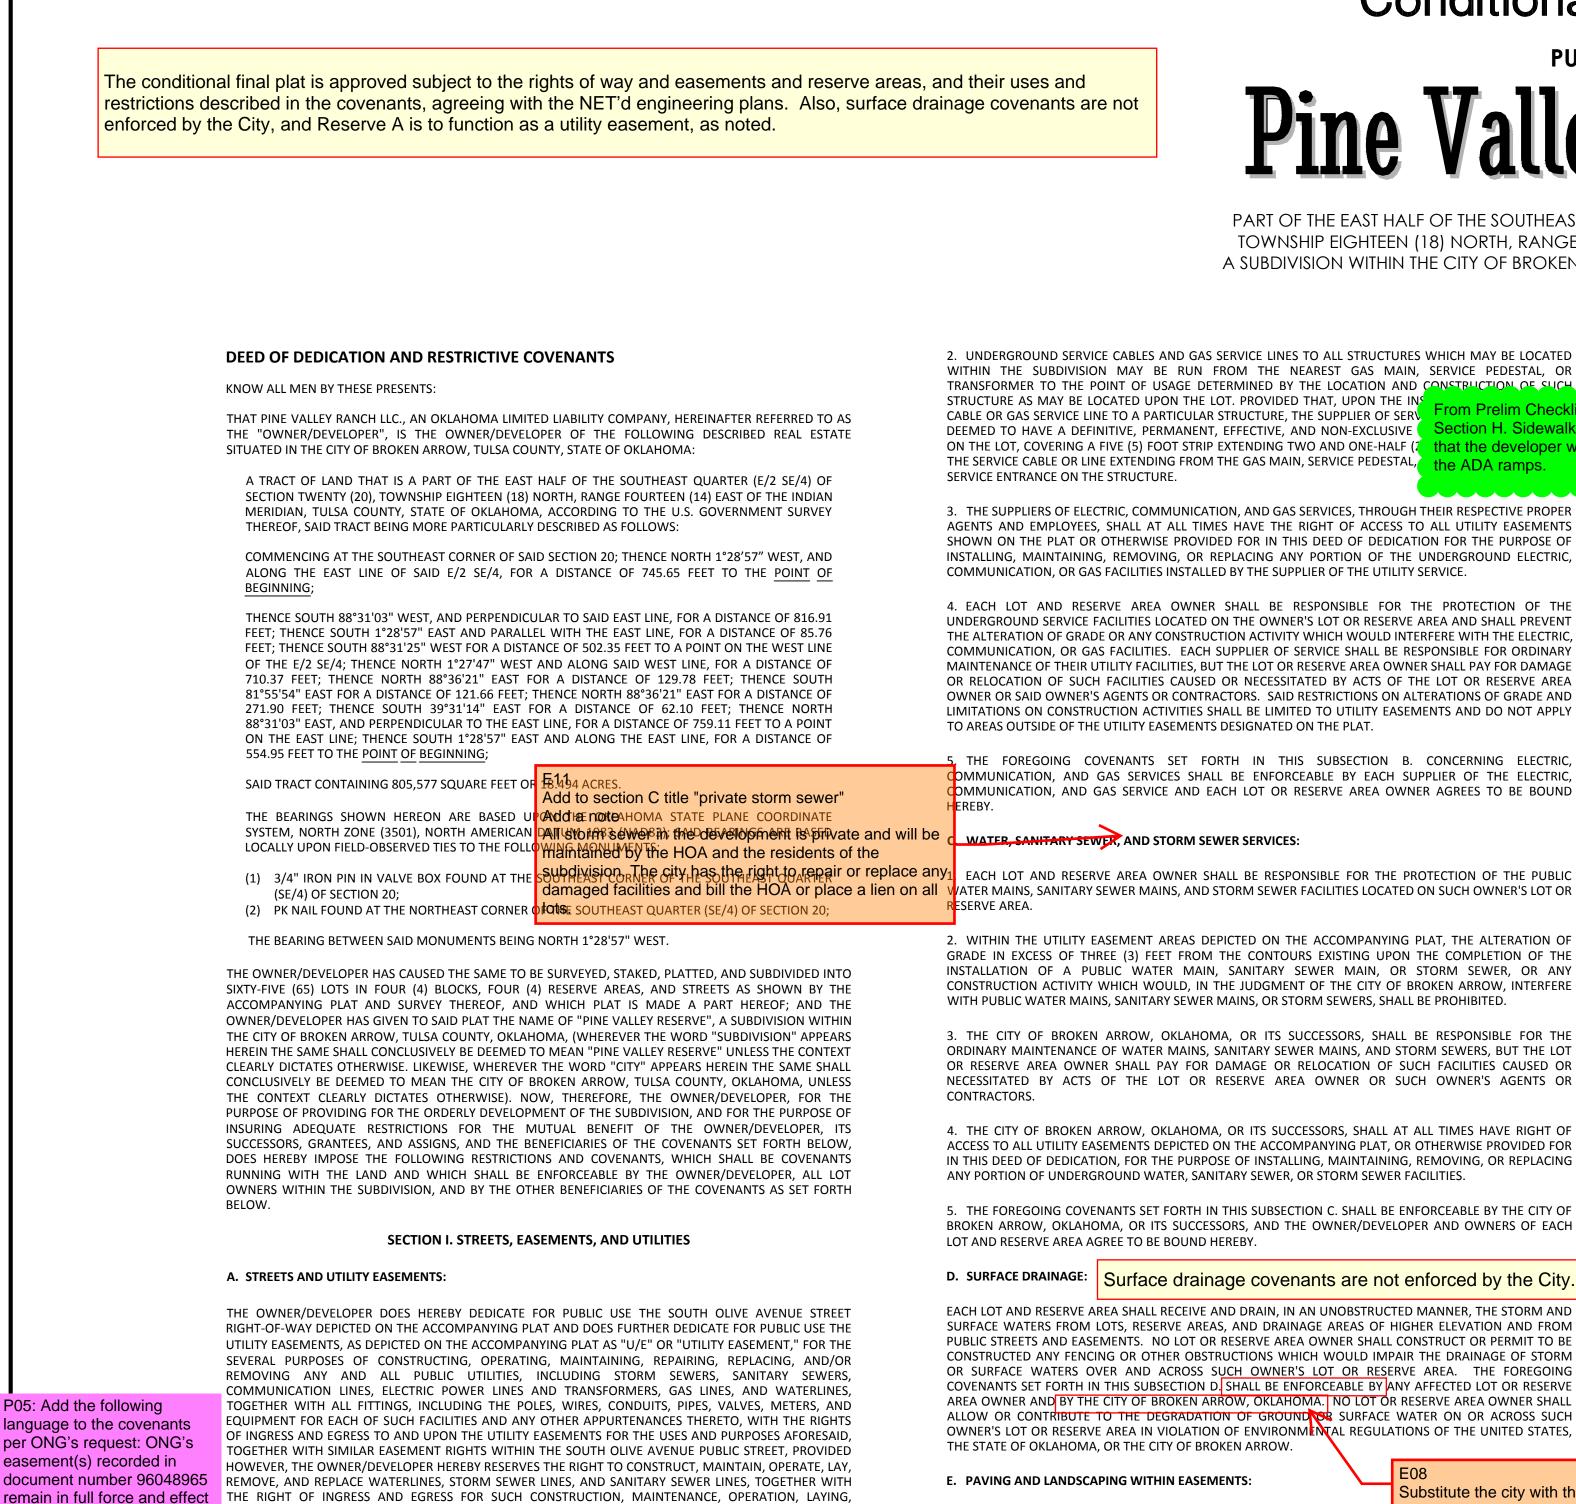

per ONG's request: ONG's easement(s) recorded in REMOVING, AND REPLACING OVER, ACROSS, AND ALONG ALL OF THE UTILITY EASEMENTS DEPICTED ON THE ONG's easement(s) pre-date PLAT, FOR THE PURPOSE OF FURNISHING WATER, STORM SEWER, AND SANITARY SEWER SERVICES TO THE the right-of-way dedication in AREA INCLUDED IN THE PLAT AND TO AREAS OUTSIDE OF THE PLAT. this plat any may prohibit or limit certain uses of ONG's other utility lines, and ONG's written consent. (As this comment was requested by ONG, it shall be satisfied between the owner and ONG. B. UNDERGROUND SERVICE: Written notification of the mutual agreement may be requested by Staff.)

THE OWNER/DEVELOPER HEREBY IMPOSES A RESTRICTIVE COVENANT, WHICH COVENANT SHALL BE BINDING right-of-way, including paving, ON EACH LOT AND RESERVE AREA OWNER AND SHALL BE ENFORCEABLE BY THE CITY OF BROKEN ARROW, OKLAHOMA, AND BY THE SUPPLIER OF ANY AFFECTED UTILITY SERVICE THAT, WITHIN THE UTILITY EASEMENTS permanent structures, without DEPICTED ON THE ACCOMPANYING PLAT, NO BUILDING, STRUCTURE, OR OTHER ABOVE OR BELOW GROUND OBSTRUCTION SHALL BE PLACED, ERECTED, INSTALLED, OR MAINTAINED, PROVIDED HOWEVER, NOTHING HEREIN SHALL BE DEEMED TO PROHIBIT DRIVES, PARKING AREAS, CURBING, OR LANDSCAPING THAT DO NOT CONSTITUTE AN OBSTRUCTION AS AFORESAID WITHIN SUCH EASEMENTS.

1. OVERHEAD LINES FOR THE SUPPLY OF ELECTRIC AND COMMUNICATION SERVICES MAY BE LOCATED WITHIN THE RIGHT-OF-WAY OF SOUTH OLIVE AVENUE AND WITHIN THE PERIMETER UTILITY EASEMENTS OF THE SUBDIVISION. STREET LIGHT POLES OR STANDARDS SHALL BE SERVED BY UNDERGROUND CABLE THROUGHOUT THE SUBDIVISION AND, EXCEPT AS PROVIDED IN THE IMMEDIATELY-PRECEDING SENTENCE, ALL SUPPLY LINES INCLUDING ELECTRIC, COMMUNICATION, AND GAS LINES SHALL BE LOCATED UNDERGROUND IN THE EASEMENT WAYS DEDICATED FOR GENERAL UTILITY SERVICES AND IN THE STREET RIGHTS-OF-WAY AS DEPICTED ON THE ACCOMPANYING PLAT. SERVICE PEDESTALS AND TRANSFORMERS, AS SOURCES OF SUPPLY AT SECONDARY VOLTAGES, MAY ALSO BE LOCATED IN THE UTILITY EASEMENTS.

DATE OF PREPARATION: November 13, 2023

Conditional Final Plat

PUD-326

Pine Valley Reserve

PART OF THE EAST HALF OF THE SOUTHEAST QUARTER (E/2 SE/4) OF SECTION TWENTY (20) TOWNSHIP EIGHTEEN (18) NORTH, RANGE FOURTEEN (14) EAST OF THE INDIAN MERIDIAN A SUBDIVISION WITHIN THE CITY OF BROKEN ARROW, TULSA COUNTY, STATE OF OKLAHOMA

2. UNDERGROUND SERVICE CABLES AND GAS SERVICE LINES TO ALL STRUCTURES WHICH MAY BE LOCATED WITHIN THE SUBDIVISION MAY BE RUN FROM THE NEAREST GAS MAIN, SERVICE PEDESTAL, OR TRANSFORMER TO THE POINT OF USAGE DETERMINED BY THE LOCATION AND CONSTRUCTION OF SUCH STRUCTURE AS MAY BE LOCATED UPON THE LOT. PROVIDED THAT, UPON THE IN CABLE OR GAS SERVICE LINE TO A PARTICULAR STRUCTURE, THE SUPPLIER OF SIDEWALKS, add ON THE LOT, COVERING A FIVE (5) FOOT STRIP EXTENDING TWO AND ONE-HALF (7 that the developer will install THE SERVICE CABLE OR LINE EXTENDING FROM THE GAS MAIN, SERVICE PEDESTAL, the ADA ramps.

3. THE SUPPLIERS OF ELECTRIC, COMMUNICATION, AND GAS SERVICES, THROUGH THEIR RESPECTIVE PROPER AGENTS AND EMPLOYEES, SHALL AT ALL TIMES HAVE THE RIGHT OF ACCESS TO ALL UTILITY EASEMENTS SHOWN ON THE PLAT OR OTHERWISE PROVIDED FOR IN THIS DEED OF DEDICATION FOR THE PURPOSE OF INSTALLING, MAINTAINING, REMOVING, OR REPLACING ANY PORTION OF THE UNDERGROUND ELECTRIC, COMMUNICATION, OR GAS FACILITIES INSTALLED BY THE SUPPLIER OF THE UTILITY SERVICE.

4. EACH LOT AND RESERVE AREA OWNER SHALL BE RESPONSIBLE FOR THE PROTECTION OF THE UNDERGROUND SERVICE FACILITIES LOCATED ON THE OWNER'S LOT OR RESERVE AREA AND SHALL PREVENT THE ALTERATION OF GRADE OR ANY CONSTRUCTION ACTIVITY WHICH WOULD INTERFERE WITH THE ELECTRIC, COMMUNICATION, OR GAS FACILITIES. EACH SUPPLIER OF SERVICE SHALL BE RESPONSIBLE FOR ORDINARY MAINTENANCE OF THEIR UTILITY FACILITIES, BUT THE LOT OR RESERVE AREA OWNER SHALL PAY FOR DAMAGE OR RELOCATION OF SUCH FACILITIES CAUSED OR NECESSITATED BY ACTS OF THE LOT OR RESERVE AREA OWNER OR SAID OWNER'S AGENTS OR CONTRACTORS. SAID RESTRICTIONS ON ALTERATIONS OF GRADE AND LIMITATIONS ON CONSTRUCTION ACTIVITIES SHALL BE LIMITED TO UTILITY EASEMENTS AND DO NOT APPLY TO AREAS OUTSIDE OF THE UTILITY EASEMENTS DESIGNATED ON THE PLAT.

5. THE FOREGOING COVENANTS SET FORTH IN THIS SUBSECTION B. CONCERNING ELECTRIC, COMMUNICATION, AND GAS SERVICES SHALL BE ENFORCEABLE BY EACH SUPPLIER OF THE ELECTRIC, DMMUNICATION, AND GAS SERVICE AND EACH LOT OR RESERVE AREA OWNER AGREES TO BE BOUND

WATER, SANITARY SEWER, AND STORM SEWER SERVICES:

damaged facilities and bill the HOA or place a lien on all water mains, sanitary sewer mains, and storm sewer facilities located on such owner's lot or

2. WITHIN THE UTILITY EASEMENT AREAS DEPICTED ON THE ACCOMPANYING PLAT, THE ALTERATION OF GRADE IN EXCESS OF THREE (3) FEET FROM THE CONTOURS EXISTING UPON THE COMPLETION OF THE INSTALLATION OF A PUBLIC WATER MAIN, SANITARY SEWER MAIN, OR STORM SEWER, OR ANY CONSTRUCTION ACTIVITY WHICH WOULD, IN THE JUDGMENT OF THE CITY OF BROKEN ARROW, INTERFERE WITH PUBLIC WATER MAINS, SANITARY SEWER MAINS, OR STORM SEWERS, SHALL BE PROHIBITED.

3. THE CITY OF BROKEN ARROW. OKLAHOMA. OR ITS SUCCESSORS. SHALL BE RESPONSIBLE FOR THE ORDINARY MAINTENANCE OF WATER MAINS, SANITARY SEWER MAINS, AND STORM SEWERS, BUT THE LOT OR RESERVE AREA OWNER SHALL PAY FOR DAMAGE OR RELOCATION OF SUCH FACILITIES CAUSED OR NECESSITATED BY ACTS OF THE LOT OR RESERVE AREA OWNER OR SUCH OWNER'S AGENTS OR

4. THE CITY OF BROKEN ARROW, OKLAHOMA, OR ITS SUCCESSORS, SHALL AT ALL TIMES HAVE RIGHT OF ACCESS TO ALL UTILITY EASEMENTS DEPICTED ON THE ACCOMPANYING PLAT, OR OTHERWISE PROVIDED FOR IN THIS DEED OF DEDICATION, FOR THE PURPOSE OF INSTALLING, MAINTAINING, REMOVING, OR REPLACING ANY PORTION OF UNDERGROUND WATER, SANITARY SEWER, OR STORM SEWER FACILITIES.

5. THE FOREGOING COVENANTS SET FORTH IN THIS SUBSECTION C. SHALL BE ENFORCEABLE BY THE CITY OF BROKEN ARROW, OKLAHOMA, OR ITS SUCCESSORS, AND THE OWNER/DEVELOPER AND OWNERS OF EACH LOT AND RESERVE AREA AGREE TO BE BOUND HEREBY.

D. SURFACE DRAINAGE: Surface drainage covenants are not enforced by the City.

EACH LOT AND RESERVE AREA SHALL RECEIVE AND DRAIN, IN AN UNOBSTRUCTED MANNER, THE STORM AND SURFACE WATERS FROM LOTS, RESERVE AREAS, AND DRAINAGE AREAS OF HIGHER ELEVATION AND FROM PUBLIC STREETS AND EASEMENTS. NO LOT OR RESERVE AREA OWNER SHALL CONSTRUCT OR PERMIT TO BE CONSTRUCTED ANY FENCING OR OTHER OBSTRUCTIONS WHICH WOULD IMPAIR THE DRAINAGE OF STORM OR SURFACE WATERS OVER AND ACROSS SUCH OWNER'S LOT OR RESERVE AREA. THE FOREGOING COVENANTS SET FORTH IN THIS SUBSECTION D. SHALL BE ENFORCEABLE BY ANY AFFECTED LOT OR RESERVE AREA OWNER AND BY THE CITY OF BROKEN ARROW, OKLAHOMA. NO LOT OR RESERVE AREA OWNER SHALL ALLOW OR CONTRIBUTE TO THE DEGRADATION OF GROUND SE SURFACE WATER ON OR ACROSS SUCH OWNER'S LOT OR RESERVE AREA IN VIOLATION OF ENVIRONMENTAL REGULATIONS OF THE UNITED STATES,

E. PAVING AND LANDSCAPING WITHIN EASEMENTS:

E08 Substitute the city with the HOA

THE OWNER OF THE LOT OR RESERVE AREA AFFECTED SHALL BE RESPONSIBLE FOR THE REPAIR OF DAMAGE TO LANDSCAPING OR PAVING OCCASIONED BY INSTALLATION OR NECESSARY MAINTENANCE OF UNDERGROUND WATER, SANITARY SEWER, STORM SEWER, NATURAL GAS, COMMUNICATION, OR ELECTRIC FACILITIES WITHIN THE UTILITY EASEMENT AREAS DEPICTED UPON THE ACCOMPANYING PLAT, PROVIDED, HOWEVER, THE CITY OF BROKEN ARROW, OKLAHOMA, OR THE SUPPLIER OF THE UTILITY SERVICE, SHALL USE REASONABLE CARE IN THE PERFORMANCE OF SUCH ACTIVITIES.

F. OTHER USES:

ALL LOT AND RESERVE AREA OWNERS HAVE THE RIGHT TO USE THE EASEMENT AREAS SITUATED WITHIN SUCH OWNER'S LOT OR RESERVE AREA IN ANY MANNER THAT WILL NOT PREVENT OR INTERFERE WITH THE EXERCISE BY THE CITY OF BROKEN ARROW OR THE PROVIDER OF UTILITY SERVICE OF THE EASEMENT RIGHTS GRANTED UNDER THIS DEDICATION.

G. ACCESS RESTRICTIONS:

1. THE OWNER HEREBY RELINQUISHES RIGHT OF INGRESS AND EGRESS TO THE ABOVE DESCRIBED PROPERTY WITHIN THE BOUNDS DESIGNATED ON THE ACCOMPANYING PLAT AS "LIMITS OF NO ACCESS" ("LNA") EXCEPT AS MAY HEREAFTER BE RELEASED, ALTERED, OR AMENDED BY THE OWNER AND BROKEN ARROW PLANNING COMMISSION, OR ITS SUCCESSORS, OR AS OTHERWISE PROVIDED BY THE STATUTES AND LAWS OF THE STATE OF OKLAHOMA PERTAINING THERETO. THE FOREGOING COVENANT CONCERNING "LIMITS OF NO ACCESS" ("LNA") SHALL BE ENFORCEABLE BY THE CITY OF BROKEN ARROW, OR ITS SUCCESSORS, AND THE LOT OWNER AGREES TO BE BOUND HEREBY.

2. ACCESS IS RESTRICTED AND ADDITIONAL SETBACK AND OTHER CITY OF BROKEN ARROW ZONING ORDINANCE RESTRICTIONS APPLY TO LOTS WITH LOT LINES DESIGNATED "RESTRICTED ACCESS" OR "R.A."

H. SIDEWALKS:

INTERIOR SIDEWALKS SHALL BE CONSTRUCTED ALONG THE INDIVIDUAL LOT'S FULL FRONTAGE WITHIN THE RESERVE AREA PRIVATE STREET RIGHT-OF-WAY BY EACH LOT OWNER IN COMPLIANCE WITH THE ENGINEERING DESIGN STANDARDS OF THE CITY OF BROKEN ARROW.

2. SIDEWALKS WILL BE CONSTRUCTED BY THE OWNER/DEVELOPER ALONG SOUTH OLIVE AVENUE AND ALL STREETS ADJACENT TO ALL RESERVE AREAS.

J. STORMWATER DRAINAGE AND DETENTION EASEMENT:

1. THE OWNER/DEVELOPER DOES HEREBY DEDICATE TO THE CITY OF BROKEN ARROW, OKLAHOMA, ITS SUCCESSORS AND ASSIGNS, A PERPETUAL, NON-EXCLUSIVE EASEMENT ON, OVER, AND ACROSS THE PROPERTY DESIGNATED AND SHOWN ON THE ACCOMPANYING PLAT AS "STORMWATER DRAINAGE AND DETENTION EASEMENT", INCLUDING, WITHOUT LIMITATION, RESERVE A, FOR THE PURPOSES OF PERMITTING THE OVERLAND AND UNDERGROUND FLOW, CONVEYANCE, DETENTION, RETENTION, AND DISCHARGE OF STORMWATER RUNOFF FROM THE VARIOUS LOTS AND RESERVE AREAS WITHIN THE SUBDIVISION AND FROM PROPERTIES NOT INCLUDED WITHIN THE SUBDIVISION.

2. STORMWATER DETENTION, RETENTION, AND DRAINAGE FACILITIES LOCATED WITHIN THE STORMWATER DRAINAGE AND DETENTION EASEMENT SHALL BE CONSTRUCTED IN ACCORDANCE WITH STANDARDS AND SPECIFICATIONS APPROVED BY THE CITY OF BROKEN ARROW, OKLAHOMA.

3. EXCEPT AS SPECIFICALLY PROVIDED HEREIN, NO FENCE, WALL, BUILDING, OR OTHER OBSTRUCTION SHALL BE PLACED OR MAINTAINED IN THE STORMWATER DRAINAGE AND DETENTION EASEMENT AREA, NOR SHALL THERE BE ANY ALTERATION OF GRADE IN SAID EASEMENT AREA UNLESS APPROVED BY THE CITY OF BROKEN ARROW, OKLAHOMA; PROVIDED, HOWEVER, THAT THE PLANTING OF TURF OR OTHER LANDSCAPING (EXCEPTING TREES AND SHRUBS) SHALL NOT REQUIRE THE APPROVAL OF THE CITY OF BROKEN ARROW. FENCES, WALLS, AND LANDSCAPING TREES OR SHRUBS INSTALLED BY THE OWNER OF RESERVE A, WITH THE APPROVAL OF THE CITY OF BROKEN ARROW, SHALL BE PERMITTED, PROVIDED THAT THE SAME DO NOT CAUSE OBSTRUCTION OF THE FLOW, CONVEYANCE, DETENTION, RETENTION, OR DISCHARGE OF STORMWATER THROUGH THE EASEMENT AREA.

4. STORMWATER DRAINAGE, DETENTION, AND RETENTION FACILITIES SHALL BE MAINTAINED BY THE OWNER OF THE LOT OR RESERVE AREA SUBJECT TO THE STORMWATER DRAINAGE AND DETENTION EASEMENT TO THE EXTENT NECESSARY TO ACHIEVE THE INTENDED STORMWATER DRAINAGE, DETENTION, AND RETENTION FUNCTIONS, INCLUDING REPAIR OF APPURTENANCES AND REMOVAL OF OBSTRUCTIONS AND SILTATION, AND SUCH OWNER SHALL PROVIDE CUSTOMARY GROUNDS MAINTENANCE WITHIN THE EASEMENT AREA IN ACCORDANCE WITH THE FOLLOWING MINIMUM STANDARDS:

- GRASS AREAS SHALL BE MOWED (IN SEASON) AT REGULAR INTERVALS OF FOUR (4) WEEKS, OR LESS.
- CONCRETE APPURTENANCES SHALL BE MAINTAINED IN GOOD CONDITION AND REPLACED IF DAMAGED.
- THE EASEMENT AREA SHALL BE KEPT FREE OF DEBRIS.
- CLEANING OF SILTATION AND VEGETATION FROM CONCRETE CHANNELS SHALL BE PERFORMED TWICE YEARLY.

5. IN THE EVENT THE OWNER OF THE LOT OR RESERVE AREA SUBJECT TO THE STORMWATER DRAINAGE AND DETENTION EASEMENT INCLUDING, WITHOUT LIMITATION, RESERVE A, SHOULD FAIL TO PROPERLY MAINTAIN THE DETENTION, RETENTION, OR OTHER DRAINAGE FACILITIES OR, IN THE EVENT OF THE PLACEMENT OF AN OBSTRUCTION WITHIN, OR THE ALTERATION OF GRADE WITHIN THE EASEMENT AREA, THE CITY OF BROKEN ARROW, OKLAHOMA, OR ITS DESIGNATED CONTRACTOR, MAY ENTER THE EASEMENT AREA AND PERFORM MAINTENANCE NECESSARY TO ACHIEVE THE INTENDED DRAINAGE, DETENTION, OR RETENTION FUNCTIONS AND MAY REMOVE ANY OBSTRUCTION OR SILTATION OR CORRECT ANY ALTERATION OF GRADE, AND THE COSTS THEREOF SHALL BE PAID BY THE OWNER OF THE LOT OR RESERVE AREA SUBJECT TO THE EASEMENT, WHICH SHALL BE THE HOMEOWNERS' ASSOCIATION UPON CONVEYANCE OF THE EASEMENT AREA OR LOT OR RESERVE AREA CONTAINING SAME TO THE ASSOCIATION. IN THE EVENT THE OWNER OF THE LOT OR RESERVE AREA SUBJECT TO THE EASEMENT FAILS TO PAY THE COSTS OF MAINTENANCE. AFTER COMPLETION OF THE MAINTENANCE AND RECEIPT OF A STATEMENT OF COSTS, THE CITY OF BROKEN ARROW, OKLAHOMA, MAY FILE OF RECORD A COPY OF THE STATEMENT OF COSTS IN THE RECORDS OF THE TULSA COUNTY CLERK, AND THEREAFTER THE COSTS SHALL BE A LIEN AGAINST THE OWNER OF THE LOT OR RESERVE AREA SUBJECT TO THE EASEMENT. A LIEN ESTABLISHED AS ABOVE PROVIDED MAY BE FORECLOSED BY THE CITY OF BROKEN ARROW, OKLAHOMA.

SECTION II. RESERVE AREAS

A. ALL RESERVE AREAS:

1. ALL RESERVE AREAS ARE HEREBY ESTABLISHED FOR THE COMMON USE AND BENEFIT OF THE OWNERS OF LOTS WITHIN THE SUBDIVISION AND ARE RESERVED FOR SUBSEQUENT CONVEYANCE TO THE HOMEOWNERS' ASSOCIATION DEFINED HEREINAFTER IN SECTION IV. (THE "ASSOCIATION").

2. ALL COSTS AND EXPENSES ASSOCIATED WITH ALL RESERVE AREAS, INCLUDING MAINTENANCE OF VARIOUS IMPROVEMENTS AND RECREATIONAL FACILITIES, SHALL BE THE RESPONSIBILITY OF THE OWNER THEREOF, WHICH OWNER SHALL BE THE HOMEOWNERS' ASSOCIATION UPON CONVEYANCE OF SAME BY OWNER/DEVELOPER TO THE ASSOCIATION. SEE SECTION IV. FOR ADDITIONAL DETAILS AND REQUIREMENTS.

4. ALL RESERVES, AND ALL IMPROVEMENTS CONSTRUCTED OR INSTALLED THEREIN, SHALL BE MAINTAINED IN A NEAT AND ORDERLY CONDITION, KEPT FREE OF THE ACCUMULATION OF TRASH AND DEBRIS, AND MOWED AND TRIMMED IN SEASON AT REGULAR INTERVALS TO PREVENT THE OVERGROWTH OF GRASS AND WEEDS.

5. THE CITY OF BROKEN ARROW, OKLAHOMA, SHALL NOT BE LIABLE FOR ANY DAMAGE OR REMOVAL OF ANY LANDSCAPING OR IRRIGATION SYSTEMS IN ANY RESERVE AREA.

6. IN THE EVENT ANY RESERVE AREA OWNER SHOULD FAIL TO MAINTAIN THE RESERVE AREA, THE CITY OF BROKEN ARROW, OKLAHOMA, OR ITS DESIGNATED CONTRACTOR, MAY ENTER THE RESERVE AREA AND PERFORM SUCH MAINTENANCE AS NECESSARY TO ACHIEVE ITS INTENDED FUNCTIONS, AND THE COSTS THEREOF SHALL BE PAID BY THE OWNER OF THE RESERVE AREA. IN THE EVENT THE RESERVE AREA OWNER FAILS TO PAY THE COST OF SAID MAINTENANCE, AFTER COMPLETION OF THE MAINTENANCE BY THE CITY OF BROKEN ARROW, OKLAHOMA, OR ITS DESIGNATED CONTRACTOR, AND PROVISION OF A STATEMENT OF COSTS FROM THE CITY TO THE RESERVE AREA OWNER, THE CITY OF BROKEN ARROW, OKLAHOMA, MAY FILE OF RECORD A COPY OF THE STATEMENT OF COSTS, AND THEREAFTER THE COSTS SHALL BE A LIEN AGAINST

SUCH RESERVE AREA, WHICH LIEN MAY BE FORECLOSED BY THE CITY OF BROKEN ARROW, OKLAHOMA,

7. EACH LOT OWNER OR RESIDENT AND/OR MEMBER OF THE HOMEOWNERS' ASSOCIATION SHALL INDEMNIFY AND HOLD HARMLESS THE OWNER/DEVELOPER AND THE CITY OF BROKEN ARROW, AND THEIR RESPECTIVE AGENTS AND REPRESENTATIVES. FROM ALL CLAIMS. DEMANDS. LIABILITIES. OR DAMAGES ARISING IN CONNECTION WITH THE OWNERSHIP OR USE OF THE FACILITIES AND IMPROVEMENTS CONSTRUCTED OR SITUATED WITHIN THE RESERVE AREAS AND FURTHER AGREES THAT NEITHER THE OWNER/DEVELOPER NOR CITY OF BROKEN ARROW SHALL BE LIABLE TO ANY LOT OR RESERVE AREA OWNER OR RESIDENT AND/OR MEMBER OF THE ASSOCIATION OR ANY GUEST, VISITOR, OR INVITEE THEREOF FOR ANY DAMAGE TO PERSON OR PROPERTY CAUSED BY ACTION. OMISSION. OR NEGLIGENCE OF A LOT OR RESERVE AREA OWNER OR RESIDENT AND/OR MEMBER OF THE ASSOCIATION OR ANY GUEST, VISITOR, OR INVITEE THEREOF.

B. RESERVE A: Reserve Area A is also for use as a utility easement.

1. RESERVE A, AS DESIGNATED ON THE ACCOMPANYING PLAT, IS HEREBY ESTABLISHED BY GRANT OF THE OWNER/DEVELOPER FOR THE COMMON USE AND BENEFIT OF THE OWNERS OF LOTS WITHIN THE SUBDIVISION AND THE OWNERS OF LOTS WITHIN THE 58.259 ACRES OF LAND ABUTTING THE SUBDIVISION TO THE NORTH AND PLATTED OR TO BE PLATTED AS "PINE VALLEY RANCH", THEIR RESPECTIVE GUESTS AND INVITEES, IS DESIGNATED TO BE USED FOR THE PURPOSES OF STORMWATER DRAINAGE AND DETENTION, OPEN SPACE, PRIVATE PARK AND/OR OTHER NEIGHBORHOOD AMENITIES, UTILITIES, AND OTHER USES AS MAY BE PERMITTED BY THE CITY OF BROKEN ARROW, OKLAHOMA, AND IS RESERVED FOR FUTURE CONVEYANCE TO THE HOMEOWNERS' ASSOCIATION.

2. RESERVE A, WHETHER OR NOT SO DESIGNATED ON THE ACCOMPANYING PLAT, IS HEREBY DEDICATED AS A STORMWATER DRAINAGE AND DETENTION EASEMENT, PROVIDED THE OWNER/DEVELOPER RETAINS THE RIGHT TO CONSTRUCT PRIVATE PARK AND/OR OTHER NEIGHBORHOOD AMENITIES AS PROVIDED HEREINABOVE.

D. RESERVE B:

1. RESERVE B, AS DESIGNATED ON THE ACCOMPANYING PLAT, IS HEREBY ESTABLISHED BY GRANT OF THE OWNER/DEVELOPER FOR THE COMMON USE AND BENEFIT OF THE OWNERS OF LOTS WITHIN THE SUBDIVISION, THEIR GUESTS AND INVITEES, FOR THE PURPOSE OF CONSTRUCTING PRIVATE STREETS PROVIDING ACCESS TO AND FROM PUBLIC STREETS, FOR PROVIDING DRAINAGE FACILITIES TO CONTROL STORMWATER RUNOFF, FOR UTILITIES, SIDEWALKS, AND FOR PROVIDING ENTRANCE SECURITY FACILITIES, DECORATIVE FENCING OR WALLS, SIGNAGE AND ENTRY FEATURES, LANDSCAPING, IRRIGATION, AND LIGHTING, AND IS RESERVED FOR SUBSEQUENT CONVEYANCE TO THE HOMEOWNERS' ASSOCIATION, TO BE FORMED PURSUANT TO SECTION IV. HEREOF FOR THE PURPOSES OF THE OWNERSHIP, ADMINISTRATION, AND MAINTENANCE OF THE PRIVATE STREETS, PRIVATE STORM SEWERS, STORMWATER DRAINAGE AND DETENTION FACILITIES. AND OTHER COMMON AREAS OF THE SUBDIVISION.

2. RESERVE B, WHETHER OR NOT SO DESIGNATED ON THE ACCOMPANYING PLAT, IS HEREBY ADDITIONALLY DEDICATED AS A UTILITY EASEMENT.

3. THE OWNER/DEVELOPER HEREBY GRANTS TO THE CITY OF BROKEN ARROW, OKLAHOMA, AND OTHER EMERGENCY RESPONSE AND GOVERNMENTAL AGENCIES HAVING JURISDICTION, THE UNITED STATES POSTAL SERVICE AND OTHER PARCEL DELIVERY SERVICES, ANY PUBLIC UTILITY PROVIDING UTILITY SERVICE TO THE SUBDIVISION, AND THE REFUSE COLLECTION SERVICE WHICH PROVIDES SERVICE WITHIN THE SUBDIVISION, THE RIGHT TO ENTER AND TRAVERSE THE PRIVATE STREETS WITHIN RESERVE B AND TO OPERATE THEREON ALL NECESSARY VEHICLES AND EQUIPMENT INCLUDING, BUT NOT LIMITED TO, POLICE AND FIRE VEHICLES AND EQUIPMENT.

4. THE OWNER/DEVELOPER, FOR ITSELF, ITS SUCCESSORS AND ASSIGNS, AND FOR THE HOMEOWNERS' ASSOCIATION TO BE FORMED PURSUANT TO SECTION IV. HEREOF, HEREBY COVENANTS WITH THE CITY OF BROKEN ARROW, OKLAHOMA, WHICH COVENANTS SHALL RUN WITH THE LAND AND INURE TO THE BENEFIT OF THE CITY OF BROKEN ARROW, OKLAHOMA, AND SHALL BE ENFORCEABLE BY THE CITY OF BROKEN ARROW, OKLAHOMA, TO:

- CONSTRUCT AND MAINTAIN STREETS EXTENDING THE FULL LENGTH OF THE PRIVATE STREETS WITHIN AND DEPICTED ON THE ACCOMPANYING PLAT AS RESERVE B, EXCEPT AS OTHERWISE PERMITTED BY THE CITY OF BROKEN ARROW, OKLAHOMA, AND MEETING OR EXCEEDING CITY DESIGN STANDARDS FOR A RESIDENTIAL PUBLIC STREET. NOTWITHSTANDING GATES. SECURE ENTRY SYSTEMS. AND RIGHT-OF-WAY WIDTHS. ALL STREET MAINTENANCE COSTS AND EXPENSES SHALL BE THE RESPONSIBILITY OF THE OWNER THEREOF, WHICH SHALL BE THE HOMEOWNERS' ASSOCIATION UPON CONVEYANCE OF RESERVE A TO THE ASSOCIATION.
- PROHIBIT THE ERECTION OF ANY ARCH OR SIMILAR STRUCTURE OVER A PRIVATE STREET DEPICTED WITHIN RESERVE B WHICH WOULD PROHIBIT ANY GOVERNMENTAL VEHICLE, SPECIFICALLY FIRE VEHICLES, FROM FREE USAGE OF THE PRIVATE STREETS.
- SECURE INSPECTION BY THE CITY OF BROKEN ARROW, OKLAHOMA OF THE PRIVATE STREETS AND SECURE CERTIFICATION BY THE CITY OF BROKEN ARROW, OKLAHOMA THAT THE PRIVATE STREETS HAVE BEEN CONSTRUCTED IN ACCORDANCE WITH THE STANDARDS ABOVE SET FORTH, OR IF THE CITY OF BROKEN ARROW, OKLAHOMA DECLINES TO INSPECT THE PRIVATE STREETS, CERTIFICATION SHALL BE SECURED FROM A LICENSED PROFESSIONAL ENGINEER THAT THE PRIVATE STREETS WERE CONSTRUCTED IN ACCORDANCE WITH THE STANDARDS ABOVE SET FORTH, AND THE REQUIRED CERTIFICATION SHALL BE FILED WITH THE BROKEN ARROW ENGINEERING DEPARTMENT PRIOR TO THE ISSUANCE OF A BUILDING PERMIT FOR ANY LOT THAT DERIVES ITS ACCESS FROM A PRIVATE STREET.

	E09	
RESERVE C:	Designating reserve C as a utility easement will	
	exclude any structures from being built in it	

RESERVE C IS DESIGNATED TO BE USED FOR A PRIVATE PARK AND/OR OTHER NEIGHBORHOOD AMENITIES, OPEN SPACE, UTILITIES, AND OTHER USES AS MAY BE PERMITTED BY THE CITY OF BROKEN ARROW, OKLAHOMA, AND IS RESERVED FOR FUTURE CONVEYANCE TO THE HOMEOWNERS' ASSOCIATION.

E. RESERVES D, E, AND F:	E10
	Identify Reserve

1. RESERVES D, E, AND F ARE DESIGNATED TO BE USED THE REPORT GHOOR PERIMETER AND INTERIOR FENCES AND WALLS, ENTRY FEATURES, SIGNAGE, LANDSCAPING, LIGHTING, IRRIGATION, OPEN SPACE AND PRIVATE PARK AND/OR OTHER NEIGHBORHOOD AMENITIES, AND OTHER USES AS MAY BE PERMITTED BY THE CITY OF BROKEN ARROW, OKLAHOMA, AND ARE RESERVED FOR FUTURE CONVEYANCE TO THE HOMEOWNERS' ASSOCIATION.

2. RESERVES D, E, AND F, WHETHER OR NOT SO DESIGNATED ON THE ACCOMPANYING PLAT, ARE HEREBY DEDICATED AS UTILITY EASEMENTS, PROVIDED THE OWNER/DEVELOPER RETAINS THE RIGHT TO CONSTRUCT PRIVATE PARK AND/OR OTHER NEIGHBORHOOD AMENITIES AS PROVIDED HEREINABOVE.

> Pine Valley Reserve CASE NO. PT SHEET 2 OF 3

DEED OF DEDICATION AND RESTRICTIVE COVENANTS (CONTINUED)

SECTION III. PLANNED UNIT DEVELOPMENT RESTRICTIONS

WHEREAS, PINE VALLEY RESERVE WAS SUBMITTED AS PART OF A PLANNED UNIT DEVELOPMENT (DESIGNATED AS PUD NO. 326 "PINE VALLEY") AS PROVIDED WITHIN THE PUD PROVISIONS OF THE ZONING ORDINANCE OF THE CITY OF BROKEN ARROW, OKLAHOMA, AS THE SAME EXISTED ON DECEMBER 21, 2021; AND WHEREAS, PUD NO. 326 WAS RECOMMENDED BY THE BROKEN ARROW PLANNING COMMISSION ON NOVEMBER 18, 2021, AND WAS APPROVED BY THE COUNCIL OF THE CITY OF BROKEN ARROW ON DECEMBER 21, 2021; AND

WHEREAS, THE PLANNED UNIT DEVELOPMENT PROVISIONS OF THE BROKEN ARROW ZONING ORDINANCE REQUIRE THE ESTABLISHMENT OF COVENANTS OF RECORD, INURING TO AND ENFORCEABLE BY THE CITY OF BROKEN ARROW. SUFFICIENT TO INSURE THE IMPLEMENTATION AND CONTINUED COMPLIANCE WITH THE APPROVED PLANNED UNIT DEVELOPMENT; AND

WHEREAS, THE OWNER DESIRES TO ESTABLISH COVENANTS OF RECORD FOR THE PURPOSE OF PROVIDING FOR AN ORDERLY DEVELOPMENT AND TO INSURE ADEQUATE COMPLIANCE WITH PUD NO. 326 FOR THE MUTUAL BENEFIT OF THE OWNER, ITS SUCCESSORS AND ASSIGNS, AND THE CITY OF BROKEN ARROW.

NOW, THEREFORE, THE OWNER DOES HEREBY IMPOSE THE FOLLOWING RESTRICTIONS AND COVENANTS WHICH SHALL BE COVENANTS RUNNING WITH THE LAND AND SHALL BE BINDING UPON THE OWNER, ITS SUCCESSORS AND ASSIGNS, AND SHALL BE ENFORCEABLE AS HEREINAFTER SET FORTH.

A. GENERAL DEVELOPMENT STANDARDS

1. THE DEVELOPMENT OF PINE VALLEY SHALL BE SUBJECT TO PUD NO. 326 AND THE PLANNED UNIT DEVELOPMENT PROVISIONS OF THE BROKEN ARROW ZONING ORDINANCE AS SUCH PROVISIONS EXISTED ON DECEMBER 21, 2021, OR AS MAY BE SUBSEQUENTLY AMENDED.

2. ACCESS AND CIRCULATION:

PUD-326 HAS APPROXIMATELY 1,890 FEET OF FRONTAGE ON SOUTH OLIVE AVENUE. THREE (3) POINTS OF ACCESS TO SOUTH OLIVE AVENUE ARE CONCEPTUALLY ILLUSTRATED ON THE PUD-326 EXHIBIT B "CONCEPTUAL SITE PLAN." A MAXIMUM OF THREE (3) POINTS OF ACCESS SHALL BE ALLOWED, PROVIDED THAT ALL SUCH POINTS OF ACCESS MEET THE SEPARATION AND ALIGNMENT REQUIREMENTS OF THE BROKEN ARROW ZONING ORDINANCE. FROM THE ADJOINING PEMBROKE PARK SUBDIVISIONS, THE SUBJECT PROPERTY HAS ADDITIONAL ACCESS VIA FOUR (4) STUB STREETS, AND THIS SITE PLAN PROPOSES TO CONNECT TO ALL OF THEM. THE ADDITIONAL CONNECTIONS WILL IMPROVE ACCESSIBILITY AND PUBLIC SAFETY FOR THE ENTIRE AREA. ALTOGETHER, THE VARIOUS CONNECTIONS WILL CREATE A WALKABLE, COHESIVE NEIGHBORHOOD.

STREETS SERVING THE SINGLE-FAMILY RESIDENTIAL PUD-326 DEVELOPMENT AREA A ("PINE VALLEY RANCH") SHALL BE PUBLIC. PUD-326 DEVELOPMENT AREA B ("PINE VALLEY RESERVE") WILL BE SERVED BY GATED, PRIVATE STREETS. ALL STREETS, PUBLIC OR PRIVATE, SHALL BE CONSTRUCTED TO MEET THE CITY OF BROKEN ARROW STANDARDS FOR PUBLIC STREETS. GATES SERVING PRIVATE STREETS OR DRIVES SHALL BE DESIGNED ACCORDING TO THE INTERNATIONAL FIRE CODE ADOPTED BY THE CITY OF BROKEN ARROW AND BE APPROVED BY THE BROKEN ARROW FIRE MARSHAL DURING THE PLATING STAGE.

THE PARK AND POND WITHIN PUD-326 DEVELOPMENT AREA B ("PINE VALLEY RESERVE") SHALL CONTAIN OFFSTREET PARKING FOR THE CONVENIENCE OF THE RESIDENTS AND THEIR GUESTS AND VISITORS WITHIN THE GATED SUBDIVISION. ADDITIONAL VISITOR PARKING WILL BE PROVIDED IF AND AS DESIGN OPPORTUNITY PRESENTS.

STREETS AND PEDESTRIAN ACCESSWAYS, CONSISTING OF SIDEWALKS AND/OR TRAILS, WILL CONNECT BOTH NEIGHBORHOODS TO THE SURROUNDING NEIGHBORHOODS, STREETS, AND FUTURE COMMERCIAL DEVELOPMENT AREA TO THE SOUTH, AND WILL BE PLANNED DURING THE ENGINEERING DESIGN AND PLATTING PHASE.

LIMITS OF NO ACCESS (LNA) WILL BE IMPOSED BY THE FUTURE PLAT(S) ALONG THE SOUTH OLIVE AVENUE FRONTAGE, EXCEPT AT APPROVED STREET INTERSECTION(S).

DURING THE SITE DEVELOPMENT AND HOME CONSTRUCTION PHASES, AND UNTIL 70% OF THE LOTS ARE PERMITTED FOR CONSTRUCTION, TEMPORARY CONSTRUCTION BARRIERS SHALL BE ERECTED AND MAINTAINED BY THE CONTRACTOR OR DEVELOPER ON ALL EXISTING STUB-STREETS TO WHICH THE SITE PRESENTLY HAS ACCESS, UNLESS OTHERWISE REQUIRED BY THE BROKEN ARROW FIRE MARSHAL.

3. SIGNAGE, LANDSCAPING, AND FENCING:

SIGNAGE, LANDSCAPING, AND FENCING: SIGNS, LANDSCAPING, AND FENCING SHALL COMPLY WITH THE APPLICABLE PROVISIONS OF THE BROKEN ARROW ZONING ORDINANCE, PROVIDED THAT FENCES ENCLOSING A FRONT YARD ("COURTYARD") SHALL BE PERMITTED UP TO FOUR (4) FEET IN HEIGHT, PROVIDED THAT NO FENCE SHALL OBSTRUCT THE SIGHT TRIANGLE AREAS AS OUTLINED IN BROKEN ARROW REGULATIONS.

NOT LESS THAN 10% OF THE NET LAND AREA SHALL BE PRESERVED AS COMMON OPEN SPACE FOR THE ENJOYMENT OF THE RESIDENTS. THE MAJORITY OF THIS AREA WILL TAKE THE FORM OF ONSITE STORMWATER DETENTION POND RESERVE AREAS, WHICH WILL INCLUDE TWO (2) OR MORE OF THE FOLLOWING: INTERCONNECTED WALKING TRAILS/SIDEWALKS, PARKS, PLAYGROUNDS, PICNIC AREAS, GAZEBO OR OTHER COVERED SHELTER, FISHING PIERS, AND AERATION FOUNTAINS. THE PARK AND POND WITHIN DEVELOPMENT AREA B ("PINE VALLEY RESERVE") SHALL CONTAIN OFFSTREET PARKING FOR THE CONVENIENCE OF THE RESIDENTS AND THEIR GUESTS AND VISITORS WITHIN THE GATED SUBDIVISION. 4. PLATTING AND SITE PLAN REQUIREMENTS:

NO BUILDING PERMIT SHALL BE ISSUED UNTIL A SUBDIVISION PLAT HAS BEEN SUBMITTED TO AND RECOMMENDED UPON BY THE BROKEN ARROW PLANNING COMMISSION AND APPROVED BY THE COUNCIL OF THE CITY OF BROKEN ARROW, AND DULY FILED OF RECORD. THE REQUIRED SUBDIVISION PLAT SHALL INCLUDE COVENANTS OF RECORD IMPLEMENTING THE DEVELOPMENT STANDARDS OF THE APPROVED PUD AND THE CITY OF BROKEN ARROW SHALL BE A BENEFICIARY THEREOF. THE PLAT WILL ALSO SERVE AS THE SITE PLAN FOR ALL RESIDENTIAL LOTS CONTAINED WITHIN THE PLAT. ANY NEIGHBORHOOD AMENITIES REQUIRING A BUILDING PERMIT SHALL SUBMIT AND RECEIVE BROKEN ARROW CITY STAFF APPROVAL OF A SITE PLAN APPLICATION.

B. DEVELOPMENT AREA A (THE NORTHERLY 30,454 SQUARE FEET OF RESERVE A "PINE VALLEY RESERVE")

GROSS LAND AREA:	1,776,555 SF	40.784 AC
NET LAND AREA:	1,776,555 SF	40.784 AC
PERMITTED USES: SINGLE-FAMILY DETACHED DWELLINGS; PARKS INCLUDING CLUBHOUSES, POOLS, AND SIMILAR FACILITIES. AND USES CUSTOMARILY ACCESSORY TO USES PE	NEIGHBORHOOD AMENITIES	
FACILITIES, AND USES CUSTOWARILT ACCESSORT TO USES PE	NIVITITED HEREIN.	
MAXIMUM NUMBER OF LOTS:	146	

MINIMUM LO MINIMUM LO MINIMUM LA MAXIMUM B MINIMUM O WIDTH AT TH MAXIMUM L MINIMUM LIV MINIMUM YA FRONT YA **REAR YAR** SIDE YARI

BUILDING HEIGHT.

SQUARE FEET OF RESERVE A)

GROSS LAND NET LAND AF PERMITTED PARKS INCL FACILITIES, A MAXIMUM MINIMUM L MINIMUM LO MINIMUM LA MAXIMUM B MINIMUM O WIDTH AT TH MAXIMUM L MINIMUM LI MINIMUM Y/ FRONT Y REAR YAF SIDE YAR CORNER

ANY YAR

BUILDING HEIGHT.

A. FORMATION OF HOMEOWNERS' ASSOCIATION:

B. MEMBERSHIP:

EVERY PERSON OR ENTITY WHO IS A RECORD OWNER OF THE FEE INTEREST OF A LOT WITHIN "PINE VALLEY RESERVE" OR "PINE VALLEY RANCH" SHALL BE A MEMBER OF THE HOMEOWNERS' ASSOCIATION. MEMBERSHIP SHALL BE APPURTENANT TO AND SHALL NOT BE SEPARATED FROM THE OWNERSHIP OF A LOT. THE ACCEPTANCE OF A DEED TO A LOT SHALL CONSTITUTE ACCEPTANCE OF MEMBERSHIP TO THE HOMEOWNERS' ASSOCIATION AS OF THE DATE OF INCORPORATION, OR AS OF THE DATE OF RECORDING OF THE DEED, WHICHEVER OCCURS LAST.

Conditional Final Plat

PUD-326

Pine Valley Reserve

PART OF THE EAST HALF OF THE SOUTHEAST QUARTER (E/2 SE/4) OF SECTION TWENTY (20), TOWNSHIP EIGHTEEN (18) NORTH, RANGE FOURTEEN (14) EAST OF THE INDIAN MERIDIAN A SUBDIVISION WITHIN THE CITY OF BROKEN ARROW, TULSA COUNTY, STATE OF OKLAHOMA

INIMUM LOT WIDTH:	60 FT
INIMUM LOT AREA:	7,000 SF
INIMUM LAND AREA PER DWELLING UNIT:	8,500 SF *
AXIMUM BUILDING HEIGHT:	2.5 STORIES AND 35 FT **
INIMUM OFF-STREET PARKING: TWO (2) PER DWELLING UNIT. IDTH AT THE FRONTAGE LINE.	DRIVEWAYS ARE RESTRICTED TO 25 FEET IN
AXIMUM LOT COVERAGE:	60%
INIMUM LIVABILITY OPEN SPACE PER DU:	3,000 SF
INIMUM YARD SETBACKS:	
FRONT YARD:	20 FT
REAR YARD:	15 FT
SIDE YARD (INTERIOR):	5 FT
CORNER LOTS, OTHER STREET:	10 FT ***
ANY YARD WITHIN 35 FEET OF ARTERIAL STREET:	35 FT FROM ARTERIAL STREET RIGHT-OF-WAY

OTHER BULK AND AREA REQUIREMENTS: AS REQUIRED WITHIN THE RS-3 DISTRICT * MINIMUM LAND AREA PER DWELLING UNIT IS SATISFIED BY THE PROPORTION OF MAXIMUM NUMBER OF

DWELLING UNITS TO GROSS LAND AREA AS PROVIDED IN SECTION 4.1.E.1.B. OF THE BROKEN ARROW ZONING ORDINANCE. LOTS ARE THEREFORE NOT SUBJECT TO THIS REQUIREMENT ON AN INDIVIDUAL BASIS. ** ARCHITECTURAL FEATURES MAY EXTEND A MAX. OF FIVE (5) FEET ABOVE MAXIMUM PERMITTED

*** WHERE A REAR YARD BACKS TO A SIDE YARD OF AN ADJACENT LOT, THE SIDE YARD SETBACK SHALL BE INCREASED TO THE ADJACENT LOT'S APPLICABLE FRONT SETBACK MINUS FIVE (5) FEET. ANY GARAGE FACING A STREET SHALL BE SET BACK NOT LESS THAN 20 FEET. ACCESS AND SETBACK RESTRICTIONS AS PRESENTLY OUTLINED IN BROKEN ARROW ZONING ORDINANCE TABLE 4.1-2 NOTE 3 SHALL APPLY TO [CORNER] LOTS.

C. DEVELOPMENT AREA B (ALL OF "PINE VALLEY RESERVE", LESS AND EXCEPT THE NORTHERLY 30,454

D AREA:	761,235 SF	17.476 AC
AREA:	761,235 SF	17.476 AC
USES: SINGLE-FAMILY DETACHED DWELLINGS; NEIGH LUDING CLUBHOUSES, POOLS, AND SIMILAR NEIG AND USES CUSTOMARILY ACCESSORY TO USES PERMITT	HBORHOOD AMENITIES,	
NUMBER OF LOTS:	125	
LOT WIDTH:	46 FT	
LOT AREA:	5,000 SF	
LAND AREA PER DWELLING UNIT:	2,200 SF *	
BUILDING HEIGHT:	2.5 STORIES AND 35 FT **	:
OFF-STREET PARKING: TWO (2) PER DWELLING UNIT. [THE FRONTAGE LINE.	DRIVEWAYS ARE RESTRICTE	ED TO 25 FEET IN
LOT COVERAGE:	50%	
LIVABILITY OPEN SPACE PER DU:	1,200 SF	
YARD SETBACKS:		
YARD:	20 FT	
ARD:	15 FT	
RD (INTERIOR):	5 FT	
R LOTS, OTHER STREET:	10 FT ***	
RD WITHIN 35 FEET OF ARTERIAL STREET:	35 FT FROM ARTERIAL STI RIGHT-OF-WAY	REET

OTHER BULK AND AREA REQUIREMENTS: AS REQUIRED WITHIN THE RM DISTRICT

* MINIMUM LAND AREA PER DWELLING UNIT IS SATISFIED BY THE PROPORTION OF MAXIMUM NUMBER OF DWELLING UNITS TO GROSS LAND AREA AS PROVIDED IN SECTION 4.1.E.1.B. OF THE BROKEN ARROW ZONING ORDINANCE. LOTS ARE THEREFORE NOT SUBJECT TO THIS REQUIREMENT ON AN INDIVIDUAL BASIS.

** ARCHITECTURAL FEATURES MAY EXTEND A MAX. OF FIVE (5) FEET ABOVE MAXIMUM PERMITTED

*** WHERE A REAR YARD BACKS TO A SIDE YARD OF AN ADJACENT LOT, THE SIDE YARD SETBACK SHALL BE INCREASED TO THE ADJACENT LOT'S APPLICABLE FRONT SETBACK MINUS FIVE (5) FEET. ANY GARAGE FACING A STREET SHALL BE SET BACK NOT LESS THAN 20 FEET. ACCESS AND SETBACK RESTRICTIONS AS PRESENTLY OUTLINED IN BROKEN ARROW ZONING ORDINANCE TABLE 4.1-2 NOTE 3 SHALL APPLY TO [CORNER] LOTS.

SECTION IV. HOMEOWNERS' ASSOCIATION

THE OWNER/DEVELOPER HAS FORMED OR SHALL CAUSE TO BE FORMED AN ASSOCIATION OF THE OWNERS OF ALL RESIDENTIAL LOTS WITHIN "PINE VALLEY RESERVE" AND A TRACT OF LAND ABUTTING TO THE NORTH AND CONTAINING APPROXIMATELY 39.766 ACRES AND TO BE PLATTED AS "PINE VALLEY RANCH" (REFERRED TO HEREIN AS THE "HOMEOWNERS' ASSOCIATION" OR "ASSOCIATION"). THE ASSOCIATION HAS BEEN OR SHALL BE ESTABLISHED IN ACCORDANCE WITH THE STATUTES OF THE STATE OF OKLAHOMA FOR THE GENERAL PURPOSES OF MAINTAINING ALL RESERVE AREAS AND OTHER COMMON AREAS WITHIN "PINE VALLEY RESERVE", "PINE VALLEY RANCH", AND ANY OTHER RESIDENTIAL SUBDIVISION WHICH MAY BE SUBSEQUENTLY ANNEXED TO OR MERGED WITH THE GEOGRAPHIC JURISDICTION OF THE ASSOCIATION, MAINTAINING ANY OTHER FACILITIES THAT ARE FOR THE COMMON USE AND BENEFIT OF THE LOTS AS THE SAME MAY BE AGREED TO BY THE MEMBERS OF THE ASSOCIATION, AND OTHERWISE ENHANCING THE VALUE, DESIRABILITY, AND ATTRACTIVENESS OF SAID SUBDIVISIONS.

C. COVENANT FOR ASSESSMENTS:

THE OWNER/DEVELOPER AND EACH SUBSEQUENT OWNER OF A LOT, BY ACCEPTANCE OF A DEED THERETO, ARE DEEMED TO COVENANT AND AGREE TO PAY TO THE HOMEOWNERS' ASSOCIATION AN ANNUAL ASSESSMENT WHICH SHALL BE NO LESS THAN THE MINIMUM AMOUNT NECESSARY TO ADEQUATELY MAINTAIN AND SUPPORT ALL COMMON AREAS OF INTEREST INCLUDING, WITHOUT LIMITATION, ALL RESERVE AREAS DESIGNATED ON THE PLAT. SAID ASSESSMENTS WILL BE ESTABLISHED BY THE BOARD OF DIRECTORS IN ACCORDANCE WITH THE DECLARATION AND THE BYLAWS OF THE HOMEOWNERS' ASSOCIATION. AN UNPAID ASSESSMENT, PROPERLY FILED, SHALL BECOME A LIEN AGAINST THE LOT WHICH IT IS MADE. THE LIEN, HOWEVER, SHALL BE SUBORDINATE TO THE LIEN OF ANY FIRST MORTGAGE.

THE STORMWATER DRAINAGE AND DETENTION FACILITY WITHIN RESERVE A OF "PINE VALLEY RESERVE" SERVES "PINE VALLEY RESERVE" AND ALSO THAT CERTAIN TRACT OF LAND ABUTTING TO THE NORTH AND CONTAINING APPROXIMATELY 39.766 ACRES AND TO BE PLATTED AS "PINE VALLEY RANCH". THE STORMWATER DRAINAGE AND DETENTION FACILITY AND AMENITIES TO BE LOCATED WITHIN "PINE VALLEY RESERVE" ARE INTENDED TO BE SHARED BETWEEN THE RESIDENTS OF BOTH SUBDIVISIONS. "PINE VALLEY RESERVE" WILL BE SERVED BY GATED, PRIVATE STREETS. THE ASSESSMENTS MAY VARY BETWEEN "PINE VALLEY RESERVE" AND "PINE VALLEY RANCH" AND WILL BE SPECIFIED WITHIN THE HOMEOWNERS' ASSOCIATION'S BYLAWS OR OTHER INSTRUMENT PREPARED BY THE OWNER/DEVELOPER FOR THIS PURPOSE.

D. SPECIAL ASSESSMENTS:

IN ADDITION TO THE ASSESSMENTS AUTHORIZED ABOVE, THE HOMEOWNERS' ASSOCIATION MAY LEVY A SPECIAL ASSESSMENT FOR THE PURPOSE OF DEFRAYING, IN WHOLE OR IN PART, THE COSTS OF ANY CONSTRUCTION OR RECONSTRUCTION, REPAIR, OR REPLACEMENT OF A CAPITAL IMPROVEMENT UPON A COMMON AREA OR ENTRYWAYS, INCLUDING THE NECESSARY FIXTURES AND PERSONAL PROPERTY RELATED THERETO AND PAYMENT FOR ANY EXPENSES DEEMED NECESSARY AND APPROPRIATE BY THE BOARD OF DIRECTORS, SUBJECT TO THE TERMS OF AND AS MORE PARTICULARLY PROVIDED IN THE HOMEOWNERS' ASSOCIATION'S BYLAWS.

E. ENFORCEMENT RIGHTS OF THE ASSOCIATION:

WITHOUT LIMITATION OF SUCH OTHER POWERS AND RIGHTS AS THE HOMEOWNERS' ASSOCIATION MAY HAVE, THE HOMEOWNERS' ASSOCIATION SHALL BE DEEMED A BENEFICIARY, TO THE SAME EXTENT AS A LOT OWNER. OF THE VARIOUS COVENANTS SET FORTH WITH THIS DEED OF DEDICATION. AND SHALL HAVE THE RIGHT TO ENFORCE ALL THE COVENANTS TO THE SAME EXTENT AS A LOT OWNER.

SECTION V. ENFORCEMENT, DURATION, AMENDMENT OR **TERMINATION, AND SEVERABILITY**

A. ENFORCEMENT:

THE RESTRICTIONS HEREIN SET FORTH ARE COVENANTS TO RUN WITH THE LAND AND SHALL BE BINDING UPON THE OWNER/DEVELOPER, ITS SUCCESSORS AND ASSIGNS. WITHIN THE PROVISIONS OF SECTION I. STREETS, EASEMENTS, AND UTILITIES, SECTION II. RESERVE AREAS, SECTION III. PLANNED UNIT DEVELOPMENT RESTRICTIONS, AND SECTION V. ENFORCEMENT, DURATION, AMENDMENT OR TERMINATION, AND SEVERABILITY ARE CERTAIN COVENANTS AND THE ENFORCEMENT RIGHTS PERTAINING THERETO, AND ADDITIONALLY THE COVENANTS WITHIN SECTIONS I., II., III., AND V., WHETHER OR NOT SPECIFICALLY THEREIN SO STATED, SHALL INURE TO THE BENEFIT OF AND SHALL BE ENFORCEABLE BY THE CITY OF BROKEN ARROW, OKLAHOMA. THE COVENANTS CONTAINED IN SECTION IV. HOMEOWNERS' ASSOCIATION SHALL INURE ONLY TO THE BENEFIT OF THE OWNERS OF THE LOTS WITHIN THE SUBDIVISION AND THE HOMEOWNERS' ASSOCIATION PROVIDED FOR IN SECTION IV. IF THE UNDERSIGNED OWNER/DEVELOPER, OR ITS SUCCESSORS OR ASSIGNS, OR OWNER OF ANY LOT WITHIN PINE VALLEY RESERVE SHALL VIOLATE ANY OF THE COVENANTS HEREIN, IT SHALL BE LAWFUL FOR THE CITY OF BROKEN ARROW, OKLAHOMA, ANY OWNER OF A LOT WITHIN PINE VALLEY RESERVE, THE HOMEOWNERS' ASSOCIATION, OR ANY OTHER BENEFICIARY AS SPECIFIED WITHIN THE CONCERNED SECTION HEREOF TO MAINTAIN ANY ACTION AT LAW OR IN EQUITY AGAINST THE PERSON OR PERSONS VIOLATING OR ATTEMPTING TO VIOLATE ANY SUCH COVENANT, TO PREVENT SUCH PERSON OR PERSONS FROM SO DOING, OR TO COMPEL COMPLIANCE WITH THE COVENANT. IN ANY JUDICIAL ACTION BROUGHT BY THE HOMEOWNERS' ASSOCIATION OR AN OWNER OF A LOT WITHIN PINE VALLEY RESERVE, WHICH ACTION SEEKS TO ENFORCE THE COVENANTS OR RESTRICTIONS SET FORTH HEREIN OR TO RECOVER DAMAGES FOR THE BREACH THEREOF, THE PREVAILING PARTY SHALL BE ENTITLED TO RECOVER REASONABLE ATTORNEY'S FEES AND COSTS AND EXPENSES INCURRED IN SUCH ACTION.

B. DURATION:

THE COVENANTS CONTAINED HEREIN SHALL RUN WITH THE LAND AND SHALL BE BINDING UPON THE UNDERSIGNED OWNER/DEVELOPER, ITS GRANTEES, SUCCESSORS, AND ASSIGNS, AND ALL PARTIES CLAIMING UNDER IT FOR A PERIOD OF TWENTY-FIVE (25) YEARS FROM THE DATE OF THE RECORDING HEREOF, AFTER WHICH TIME SAID COVENANTS SHALL BE AUTOMATICALLY EXTENDED THEREAFTER FOR SUCCESSIVE PERIODS OF TEN (10) YEARS UNLESS AMENDED OR TERMINATED AS HEREINAFTER PROVIDED.

C. AMENDMENT OR TERMINATION:

THE COVENANTS CONTAINED WITHIN SECTIONS I., II., AND V. MAY BE AMENDED OR TERMINATED AT ANY TIME BY A WRITTEN INSTRUMENT SIGNED AND ACKNOWLEDGED BY THE OWNER OF THE LAND TO WHICH THE AMENDMENT OR TERMINATION IS TO BE APPLICABLE AND APPROVED BY THE BROKEN ARROW PLANNING COMMISSION, OR ITS SUCCESSORS, WITH THE APPROVAL OF THE CITY OF BROKEN ARROW, OKLAHOMA. THE COVENANTS CONTAINED WITHIN SECTION III. PLANNED UNIT DEVELOPMENT RESTRICTIONS MAY BE AMENDED OR TERMINATED AT ANY TIME BY A WRITTEN INSTRUMENT SIGNED AND ACKNOWLEDGED BY THE OWNER OF THE LAND TO WHICH THE AMENDMENT OR TERMINATION IS TO BE APPLICABLE AND APPROVED BY THE BROKEN ARROW PLANNING COMMISSION, OR ITS SUCCESSORS. NOTWITHSTANDING THE FOREGOING, THE COVENANTS CONTAINED WITHIN SECTION III. SHALL BE DEEMED AMENDED (WITHOUT NECESSITY OF EXECUTION OF AN AMENDING DOCUMENT) UPON APPROVAL OF AN AMENDMENT TO PUD NO. 326 BY THE BROKEN ARROW PLANNING COMMISSION AND RECORDING OF A CERTIFIED COPY OF THE MINUTES OF THE BROKEN ARROW PLANNING COMMISSION WITH THE TULSA COUNTY CLERK. THE COVENANTS WITHIN SECTION IV. AND WITHIN ANY OTHER PART HEREOF WHICH DID NOT ORIGINALLY REQUIRE THE APPROVAL OF THE CITY OF BROKEN ARROW, OKLAHOMA, MAY BE AMENDED OR TERMINATED AT ANY TIME WITH 65 PERCENT AGREEMENT OF ALL OWNERS OF LOTS WITHIN PINE VALLEY RESERVE WITHOUT APPROVAL FROM THE CITY OF BROKEN ARROW. THE PROVISIONS OF ANY INSTRUMENT AMENDING OR TERMINATING COVENANTS SHALL BE EFFECTIVE FROM AND AFTER THE DATE IT IS PROPERLY RECORDED.

D. SEVERABILITY:

IN WITNESS WHEREOF, THE OWNER HAS CAUSED THESE PRESENTS TO BE EXECUTED THIS _____ DAY OF _, 2024. PINE VALLEY RANCH LLC. AN OKLAHOMA LIMITED LIABILITY COMPANY RICK DODSON, GENERAL MANAGER STATE OF OKLAHOMA) SS COUNTY OF TULSA BEFORE ME, THE UNDERSIGNED, A NOTARY PUBLIC IN AND FOR SAID COUNTY AND STATE, ON ___, 2024, PERSONALLY APPEARED RICK DODSON , TO ME KNOWN TO BE THIS DAY OF THE IDENTICAL PERSON WHO SUBSCRIBED THE NAME OF PINE VALLEY RANCH LLC. TO THE FOREGOING INSTRUMENT, AS ITS GENERAL MANAGER, AND ACKNOWLEDGED TO ME THAT HE EXECUTED THE SAME AS HIS FREE AND VOLUNTARY ACT AND DEED AND AS THE FREE AND VOLUNTARY ACT AND DEED OF PINE VALLEY RANCH LLC. FOR THE USES AND PURPOSES THEREIN SET FORTH. GIVEN UNDER MY HAND AND SEAL THE DAY AND YEAR LAST ABOVE WRITTEN. EXP 03/08/2024

INVALIDATION OF ANY RESTRICTION SET FORTH HEREIN, OR ANY PART THEREOF, BY AN ORDER, JUDGMENT,

RESTRICTIONS OR ANY PART THEREOF SET FORTH HEREIN. WHICH SHALL REMAIN IN FULL FORCE AND EFFECT.

OR DECREE OF ANY COURT, OR OTHERWISE, SHALL NOT INVALIDATE OR AFFECT ANY OF THE OTHER

03/08/2024

NOTARY PUBLIC

CERTIFICATE OF SURVEY

I. DAN E. TANNER, A LICENSED PROFESSIONAL LAND SURVEYOR IN THE STATE OF OKLAHOMA, DO HEREBY CERTIFY THAT I HAVE CAREFULLY AND ACCURATELY SURVEYED. SUBDIVIDED. AND PLATTED THE TRACT OF LAND DESCRIBED HEREINABOVE, AND THAT THE ACCOMPANYING PLAT IS A TRUE REPRESENTATION OF A SURVEY MADE ON THE GROUND USING GENERALLY ACCEPTED PRACTICES, AND MEETS OR EXCEEDS THE OKLAHOMA MINIMUM STANDARDS FOR THE PRACTICE OF LAND SURVEYING.

WITNESS MY HAND AND SEAL THIS	DAY OF	, 2024.
	BY: DAN E. TANNER LICENSED PROFESSION	Dan Edwin SURVEYOR
	OKLAHOMA NO. 1435	
STATE OF OKLAHOMA)) SS		
COUNTY OF TULSA)		
DAY OF THE IDENTICAL PERSON WHO SUB	, 2024, PERSONALLY APPEARE SSCRIBED HIS NAME AS LICENSE	AID COUNTY AND STATE, ON THIS D TO ME DAN E. TANNER KNOWN TO BE D PROFESSIONAL LAND SURVEYOR TO THE ND DEED, FOR THE USES AND PURPOSES
GIVEN UNDER MY HAND AND SEAL	. THE DAY AND YEAR LAST ABOVE	WRITTEN.
03/08/2024		# 12002299
MY COMMISSION EXPIRES	NOTARY PUBLIC	PUBLIC: OF

Pine Valley Reserve CASE NO. PT -SHEET 3 OF 3