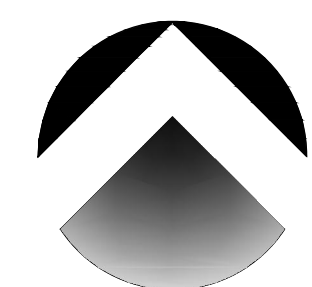


Conditional Final Plat

Spring Creek Crossing

PART OF THE SOUTHWEST QUARTER OF THE SOUTHEAST QUARTER (SW/4 SE/4) OF SECTION THIRTY-FIVE (35),
TOWNSHIP EIGHTEEN (18) NORTH, RANGE FOURTEEN (14) EAST OF THE INDIAN MERIDIAN
A SUBDIVISION WITHIN THE CITY OF BROKEN ARROW, TULSA COUNTY, STATE OF OKLAHOMA

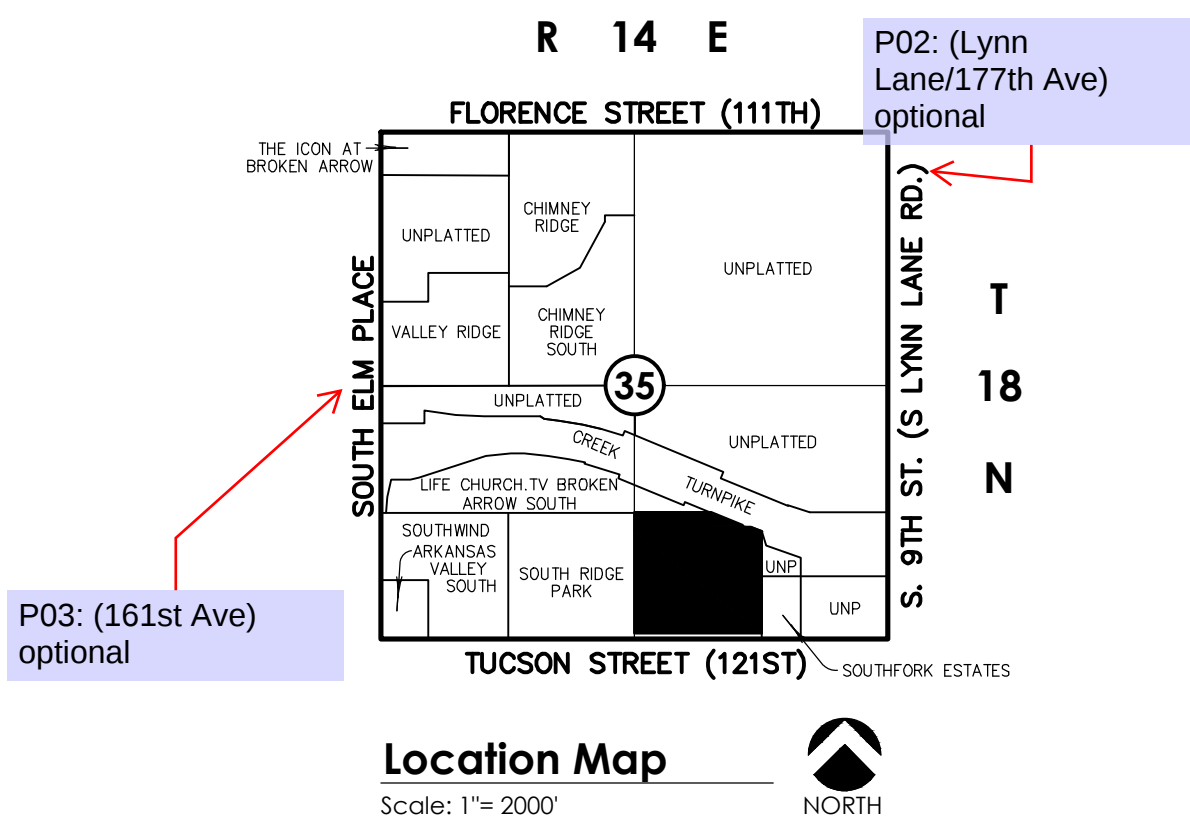


Scale: 1"= 80'
Tanner Consulting

- LEGEND
- B/L BUILDING LINE
 - BK PG BOOK & PAGE
 - CB CHORD BEARING
 - CD CHORD DISTANCE
 - CL CENTERLINE
 - Δ DELTA ANGLE
 - DOC DOCUMENT
 - ESMT EASEMENT
 - F/E FENCE & LANDSCAPE EASEMENT
 - FFE FINISHED FLOOR ELEVATION
 - GOV'T GOVERNMENT
 - LNA LIMITS OF NO ACCESS
 - ODE OVERLAND DRAINAGE EASEMENT
 - R.A. RESTRICTED ACCESS
 - RES. RESERVE
 - RWE RETAINING WALL EASEMENT
 - R/W RIGHT-OF-WAY
 - U/E UTILITY EASEMENT
 - 1/34 ADDRESS ASSIGNED
 - FOUND MONUMENT (SEE NOTE 2)
 - SET MONUMENT (SEE NOTE 2)

OWNER:
Tulsa L Dev., LLC
CONTACT: DEREK KENNEDY
EMAIL: DEREK.KENNEDY@RCH.COM
4058 North College
Suite 300 Box 9
Fayetteville, Arkansas 72703
Phone: (479) 455-9090

SURVEYOR/ENGINEER:
Tanner Consulting, L.L.C.
DAN E. TANNER, P.L.S. NO. 1435
OK CA NO. 2661, EXPIRES 6/30/2025
EMAIL: DAN@TANNERBATHSHOP.COM
5323 South Lewis Avenue
Tulsa, Oklahoma 74105
Phone: (918) 745-9929



SUBDIVISION CONTAINS:

ONE HUNDRED AND THIRTY-TWO (132) LOTS
IN SIX (6) BLOCKS
WITH THREE (3) RESERVE AREAS

GROSS SUBDIVISION AREA: 36.991 ACRES

Benchmark #1

CHISELED X FOUND IN CONCRETE
WALKING PATH, LOCATED ON THE SOUTH
SIDE OF PROPERTY, APPROXIMATELY
503.91' WEST AND 38.79' SOUTH OF THE
SOUTHEAST PROPERTY CORNER
(367288.43N, 262352.15E)

ELEVATION=693.37 (NAVD88)

Notes:

- THIS PLAT MEETS THE OKLAHOMA MINIMUM STANDARDS FOR THE PRACTICE OF
LAND SURVEYING AS ADOPTED BY THE OKLAHOMA STATE BOARD OF LICENSURE
FOR PROFESSIONAL ENGINEERS AND LAND SURVEYORS.
- ALL PROPERTY CORNERS ARE FOUND OR SET 3/8" IRON REBAR WITH YELLOW CAP
STAMPED "TANNER 1435" UNLESS OTHERWISE NOTED.
- THE BEARINGS SHOWN HEREON ARE BASED UPON THE OKLAHOMA STATE PLANE
COORDINATE SYSTEM, NORTH ZONE (3501), NORTH AMERICAN DATUM 1983
(NAD83); SAID BEARINGS ARE BASED LOCALLY UPON FIELD-OBSERVED TIES TO
THE FOLLOWING MONUMENTS:
(A) CHISELED X FOUND AT THE SOUTHWEST CORNER OF SECTION 35;
(B) 3/8" IRON PIN FOUND AT THE SOUTHWEST CORNER OF THE SOUTHEAST
QUARTER (SE/4) OF SECTION 35;
THE BEARING BETWEEN SAID MONUMENTS BEING NORTH 88°35'38" EAST.
- ADDRESSES SHOWN ON THIS PLAT WERE PROVIDED BY THE CITY OF BROKEN
ARROW AND WERE ACCURATE AT THE TIME THE PLAT WAS FILED. ADDRESSES
ARE SUBJECT TO CHANGE AND SHOULD NEVER BE RELIED ON IN PLACE OF THE
LEGAL DESCRIPTION.
- ACCESS AT THE TIME OF PLAT WAS PROVIDED BY EAST TUCSON STREET AND BY
EAST RALEIGH STREET, BOTH BEING PUBLIC STREETS.
- ACCESS IS RESTRICTED AND ADDITIONAL SETBACK AND OTHER CITY OF BROKEN
ARROW ZONING ORDINANCE RESTRICTIONS APPLY TO LOTS WITH LOT LINES
DESIGNATED "RESTRICTED ACCESS" OR "R.A." THIS NOTE IS IN REFERENCE AND
SUBORDINATE TO A SIMILAR PROVISION IN THE RESTRICTIVE COVENANTS.
- STORMWATER DETENTION ACCOMMODATIONS FOR THIS SITE ARE PROVIDED IN
ACCORDANCE WITH FEE-IN-LIEU OF DETENTION DETERMINATION
#DD-100523-65.
- ALL LOTS REQUIRE BACKFLOW PREVENTION PER BROKEN ARROW CITY
ORDINANCE.

P05: Per Previous review: Note wedge shaped lots are
measured at the B/L

Curve Table

CURVE	LENGTH(L)	RADIUS(R)	DELTA(Δ)	CHORD(BRG)(CB)	CHORD(DI)(CD)
1	43.11'	185.00'	13°21'04"	N5°17'46"E	43.01'
2	39.27'	25.00'	90°00'00"	N43°37'14"E	35.36'
3	39.27'	25.00'	90°00'00"	N46°22'46"W	35.36'
4	21.03'	25.00'	48°11'23"	N46°31'33"E	20.41'
5	241.19'	50.00'	276°22'46"	N1°22'46"W	66.67'
6	21.03'	25.00'	48°11'23"	N67°17'04"W	20.41'
7	38.45'	275.00'	8°00'38"	N5°23'05"W	38.42'
8	50.73'	325.00'	8°56'36"	N5°51'04"W	50.68'
9	39.65'	25.00'	90°51'46"	N54°49'17"W	35.62'
10	39.64'	25.00'	90°51'20"	N57°06'18"E	35.62'
11	62.72'	405.00'	8°52'24"	N84°11'02"E	62.66'
12	75.28'	355.00'	12°09'00"	N82°32'44"E	75.14'
13	16.09'	25.00'	36°52'12"	N19°48'52"W	15.81'
14	142.89'	50.00'	163°44'23"	N43°37'14"E	98.99'
15	16.09'	25.00'	36°52'12"	N72°56'40"W	15.81'
16	60.54'	300.00'	11°33'43"	N85°35'54"W	60.44'
17	392.70'	250.00'	90°00'00"	N46°22'46"W	353.55'
18	35.41'	25.00'	81°09'00"	N59°36'27"E	32.52'
19	35.41'	25.00'	81°09'00"	N21°32'34"W	32.52'
20	318.03'	300.00'	60°44'18"	N31°44'55"W	303.34'
21	85.88'	405.00'	12°09'00"	N82°32'44"E	85.72'
22	50.11'	355.00'	8°05'16"	N84°34'36"E	50.07'
23	117.81'	75.00'	90°00'01"	N46°22'45"W	106.07'
24	143.29'	50.00'	164°11'35"	N43°50'50"E	99.05'
25	16.29'	25.00'	37°19'23"	N72°43'04"W	16.00'



Conditional Final Plat

PUD-001360-2024

Spring Creek Crossing

PART OF THE SOUTHWEST QUARTER OF THE SOUTHEAST QUARTER (SW/4 SE/4) OF SECTION THIRTY-FIVE (35), TOWNSHIP EIGHTEEN (18) NORTH, RANGE FOURTEEN (14) EAST OF THE INDIAN MERIDIAN A SUBDIVISION WITHIN THE CITY OF BROKEN ARROW, TULSA COUNTY, STATE OF OKLAHOMA

DEED OF DEDICATION AND RESTRICTIVE COVENANTS

KNOW ALL MEN BY THESE PRESENTS:

THAT TULSA L DEV., LLC, AN OKLAHOMA LIMITED LIABILITY COMPANY, HEREINAFTER REFERRED TO AS THE "OWNER" AND/OR "DECLARANT", IS THE OWNER OF THE FOLLOWING DESCRIBED REAL PROPERTY SITUATED IN THE CITY OF BROKEN ARROW, TULSA COUNTY, STATE OF OKLAHOMA:

A TRACT OF LAND THAT IS A PART OF THE SOUTHWEST QUARTER OF THE SOUTHEAST QUARTER (SW/4 SE/4) OF SECTION THIRTY-FIVE (35), TOWNSHIP EIGHTEEN (18) NORTH, RANGE FOURTEEN (14) EAST OF THE INDIAN MERIDIAN, TULSA COUNTY, STATE OF OKLAHOMA, ACCORDING TO THE U.S. GOVERNMENT SURVEY THEREOF, SAID TRACT BEING MORE PARTICULARLY DESCRIBED AS FOLLOWS:

COMMENCING AT THE SOUTHWEST CORNER OF SAID SW/4 SE/4; THENCE NORTH 1°22'46" WEST AND ALONG THE WEST LINE OF THE SW/4 SE/4, FOR A DISTANCE OF 60.00 FEET TO A POINT ON THE PRESENT NORTH RIGHT-OF-WAY LINE OF EAST TUCSON STREET, SAID POINT BEING THE POINT OF BEGINNING;

THENCE CONTINUING NORTH 1°22'46" WEST AND ALONG SAID WEST LINE OF THE SW/4 SE/4, FOR A DISTANCE OF 1261.94 FEET TO THE NORTHWEST CORNER OF THE SW/4 SE/4; THENCE NORTH 88°36'25" EAST AND ALONG THE NORTH LINE OF THE SW/4 SE/4, FOR A DISTANCE OF 795.67 FEET TO A POINT ON THE PRESENT SOUTHERLY RIGHT-OF-WAY LINE OF THE CREEK TURNPIKE (OKLAHOMA STATE HIGHWAY 364); THENCE ALONG SAID SOUTHERLY RIGHT-OF-WAY LINE FOR THE FOLLOWING FOUR (4) COURSES:

SOUTH 68°42'31" EAST FOR A DISTANCE OF 351.58 FEET; THENCE SOUTH 1°24'32" EAST FOR A DISTANCE OF 14.41 FEET; THENCE NORTH 88°36'25" EAST FOR A DISTANCE OF 86.60 FEET; THENCE SOUTH 68°30'02" EAST FOR A DISTANCE OF 123.11 FEET TO A POINT ON THE EAST LINE OF THE SW/4 SE/4;

THENCE SOUTH 1°24'32" EAST AND ALONG SAID EAST LINE, FOR A DISTANCE OF 1063.83 FEET TO A POINT ON SAID NORTH RIGHT-OF-WAY LINE OF EAST TUCSON STREET; THENCE SOUTH 88°35'51" WEST AND ALONG THE NORTH RIGHT-OF-WAY LINE, FOR A DISTANCE OF 1320.67 FEET TO THE POINT OF BEGINNING;

SAID TRACT CONTAINING 1,611,344 SQUARE FEET OR 36.991 ACRES.

THE BEARINGS SHOWN HEREON ARE BASED UPON THE OKLAHOMA STATE PLANE COORDINATE SYSTEM, NORTH ZONE (3501), NORTH AMERICAN DATUM 1983 (NAD83); SAID BEARINGS ARE BASED LOCALLY UPON FIELD-OBSERVED TIES TO THE FOLLOWING MONUMENTS:

- (1) CHISELED X FOUND AT THE SOUTHWEST CORNER OF THE OF SECTION 35;
- (2) 3/8" IRON PIN FOUND AT THE SOUTHWEST CORNER OF THE SOUTHEAST QUARTER (SE/4) OF SECTION 35;

THE BEARING BETWEEN SAID MONUMENTS BEING NORTH 88°35'38" EAST.

THE OWNER HAS CAUSED THE SAME TO BE SURVEYED, STAKED, PLATTED, GRANTED, DONATED, CONVEYED, DEDICATED, ACCESS RIGHTS RESERVED, AND SUBDIVIDED INTO ONE HUNDRED THIRTY-TWO (132) LOTS IN SIX (6) BLOCKS, ALONG WITH RESERVE AREAS, COMMON AREAS, AND STREETS IN CONFORMITY WITH THE ACCOMPANYING PLAT AND SURVEY THEREOF, AND WHICH PLAT IS MADE A PART HEREOF; AND THE OWNER HAS GIVEN TO SAID PLAT THE NAME OF "SPRING CREEK CROSSING", A SUBDIVISION WITHIN THE CITY OF BROKEN ARROW, TULSA COUNTY, OKLAHOMA, (WHEREVER THE WORD "SUBDIVISION" APPEARS HEREIN THE SAME SHALL CONCLUSIVELY BE DEEMED TO MEAN "SPRING CREEK CROSSING" UNLESS THE CONTEXT CLEARLY DICTATES OTHERWISE. LIKEWISE, WHEREVER THE WORD "CITY" APPEARS HEREIN THE SAME SHALL CONCLUSIVELY BE DEEMED TO MEAN THE CITY OF BROKEN ARROW, TULSA COUNTY, OKLAHOMA, UNLESS THE CONTEXT CLEARLY DICTATES OTHERWISE). NOW, THEREFORE, THE OWNER, FOR THE PURPOSE OF PROVIDING FOR THE ORDERLY DEVELOPMENT OF THE SUBDIVISION, AND FOR THE PURPOSE OF INSURING ADEQUATE RESTRICTIONS FOR THE MUTUAL BENEFIT OF THE OWNER, ITS SUCCESSORS, GRANTEES, AND ASSIGNS, AND THE BENEFICIARIES OF THE COVENANTS SET FORTH BELOW, DOES HEREBY IMPOSE THE FOLLOWING RESTRICTIONS AND COVENANTS, WHICH SHALL BE COVENANTS RUNNING WITH THE LAND AND WHICH SHALL BE ENFORCEABLE BY THE OWNER, ALL LOT OWNERS WITHIN THE SUBDIVISION, AND BY THE OTHER BENEFICIARIES OF THE COVENANTS AS SET FORTH BELOW.

SECTION I. PUBLIC STREETS, EASEMENTS, AND UTILITIES

A. PUBLIC STREETS AND UTILITY EASEMENTS:

THE OWNER DOES HEREBY DEDICATE FOR PUBLIC USE THE STREET RIGHTS-OF-WAY DEPICTED ON THE ACCOMPANYING PLAT AND DOES FURTHER DEDICATE FOR PUBLIC USE THE UTILITY EASEMENTS, AS DEPICTED ON THE ACCOMPANYING PLAT AS "U/E" OR "UTILITY EASEMENT," FOR THE SEVERAL PURPOSES OF CONSTRUCTING, OPERATING, MAINTAINING, REPAIRING, REPLACING, AND/OR REMOVING ANY AND ALL PUBLIC UTILITIES, INCLUDING STORM SEWERS, SANITARY SEWERS, COMMUNICATION LINES, ELECTRIC POWER LINES AND TRANSFORMERS, GAS LINES, AND WATERLINES, TOGETHER WITH ALL FITTINGS, INCLUDING THE POLES, WIRES, CONDUITS, PIPES, VALVES, METERS, AND EQUIPMENT FOR EACH OF SUCH FACILITIES AND ANY OTHER APPURTENANCES THERETO, WITH THE RIGHTS OF INGRESS AND EGRESS TO AND UPON THE UTILITY EASEMENTS FOR THE USES AND PURPOSES AFORESAID, TOGETHER WITH SIMILAR EASEMENT RIGHTS WITHIN THE PUBLIC STREETS, PROVIDED HOWEVER, THE OWNER HEREBY RESERVES THE RIGHT TO CONSTRUCT, MAINTAIN, OPERATE, LAV, REMOVE, AND REPLACE WATERLINES, STORM SEWER FACILITIES, AND SANITARY SEWER LINES, TOGETHER WITH THE RIGHT OF INGRESS AND EGRESS FOR SUCH CONSTRUCTION, MAINTENANCE, OPERATION, LAYING, REMOVING, AND REPLACING OVER, ACROSS, AND ALONG ALL OF THE UTILITY EASEMENTS DEPICTED ON THE PLAT, FOR THE PURPOSE OF FURNISHING WATER, STORM SEWER, AND SANITARY SEWER SERVICES TO THE AREA INCLUDED IN THE PLAT AND TO AREAS OUTSIDE OF THE PLAT.

THE OWNER HEREBY IMPOSES A RESTRICTIVE COVENANT, WHICH COVENANT SHALL BE BINDING ON EACH LOT AND RESERVE AREA OWNER AND SHALL BE ENFORCEABLE BY THE CITY OF BROKEN ARROW, OKLAHOMA, AND BY THE SUPPLIER OF ANY AFFECTED UTILITY SERVICE THAT, WITHIN THE UTILITY EASEMENTS DEPICTED ON THE ACCOMPANYING PLAT, NO BUILDING, STRUCTURE, OR OTHER ABOVE OR BELOW GROUND OBSTRUCTION SHALL BE PLACED, ERECTED, INSTALLED, OR MAINTAINED, PROVIDED HOWEVER, NOTHING HEREIN SHALL BE DEEMED TO PROHIBIT

DRIVES, PARKING AREAS, CURBING, OR LANDSCAPING THAT DO NOT CONSTITUTE AN OBSTRUCTION AS AFORESAID WITHIN SUCH EASEMENTS.

B. UNDERGROUND SERVICE:

1. OVERHEAD LINES FOR THE SUPPLY OF ELECTRIC AND COMMUNICATION SERVICES MAY BE LOCATED WITHIN THE RIGHT-OF-WAY ADJACENT TO THE SOUTH RIGHT-OF-WAY LINE OF THE CREEK TURNPIKE (OKLAHOMA STATE HIGHWAY 364) AS DEDICATED BY THIS PLAT AND WITHIN THE PERIMETER UTILITY EASEMENTS OF THE SUBDIVISION. STREET LIGHT POLES OR STANDARDS SHALL BE SERVED BY UNDERGROUND CABLE THROUGHOUT THE SUBDIVISION AND, EXCEPT AS PROVIDED IN THE IMMEDIATELY-PRECEDING SENTENCE, ALL SUPPLY LINES INCLUDING ELECTRIC, COMMUNICATION, AND GAS LINES SHALL BE LOCATED UNDERGROUND IN THE EASEMENT WAYS DEDICATED FOR GENERAL UTILITY SERVICES AND IN THE STREET RIGHTS-OF-WAY AS DEPICTED ON THE ACCOMPANYING PLAT. SERVICE PEDESTALS AND TRANSFORMERS, AS SOURCES OF SUPPLY AT SECONDARY VOLTAGES, MAY ALSO BE LOCATED IN THE UTILITY EASEMENTS.

2. UNDERGROUND SERVICE CABLES AND GAS SERVICE LINES TO ALL STRUCTURES WHICH MAY BE LOCATED WITHIN THE SUBDIVISION MAY BE RUN FROM THE NEAREST GAS MAIN, SERVICE PEDESTAL, OR TRANSFORMER TO THE POINT OF USAGE DETERMINED BY THE LOCATION AND CONSTRUCTION OF SUCH STRUCTURE AS MAY BE LOCATED UPON THE LOT. PROVIDED THAT, UPON THE INSTALLATION OF A SERVICE CABLE OR GAS SERVICE LINE TO A PARTICULAR STRUCTURE, THE SUPPLIER OF SERVICE SHALL THEREAFTER BE DEEMED TO HAVE A DEFINITIVE, PERMANENT, EFFECTIVE, AND NON-EXCLUSIVE RIGHT-OF-WAY EASEMENT ON THE LOT, COVERING A FIVE (5) FOOT STRIP EXTENDING TWO AND ONE-HALF (2.5) FEET ON EACH SIDE OF THE SERVICE CABLE OR LINE EXTENDING FROM THE GAS MAIN, SERVICE PEDESTAL, OR TRANSFORMER TO THE SERVICE ENTRANCE ON THE STRUCTURE.

3. THE SUPPLIERS OF ELECTRIC, COMMUNICATION, AND GAS SERVICES, THROUGH THEIR RESPECTIVE PROPER AGENTS AND EMPLOYEES, SHALL AT ALL TIMES HAVE THE RIGHT OF ACCESS TO ALL UTILITY EASEMENTS SHOWN ON THE PLAT OR OTHERWISE PROVIDED FOR IN THIS DEED OF DEDICATION FOR THE PURPOSE OF INSTALLING, MAINTAINING, REMOVING, OR REPLACING ANY PORTION OF THE UNDERGROUND ELECTRIC, COMMUNICATION, OR GAS FACILITIES INSTALLED BY THE SUPPLIER OF THE UTILITY SERVICE.

4. EACH LOT AND RESERVE AREA OWNER SHALL BE RESPONSIBLE FOR THE PROTECTION OF THE UNDERGROUND SERVICE FACILITIES LOCATED ON THE OWNER'S LOT OR RESERVE AREA AND SHALL PREVENT THE ALTERATION OF GRADE OR ANY CONSTRUCTION ACTIVITY WHICH WOULD INTERFERE WITH THE ELECTRIC, COMMUNICATION, OR GAS FACILITIES. EACH SUPPLIER OF SERVICE SHALL BE RESPONSIBLE FOR ORDINARY MAINTENANCE OF THEIR UTILITY FACILITIES, BUT THE LOT OR RESERVE AREA OWNER SHALL PAY FOR DAMAGE OR RELOCATION OF SUCH FACILITIES CAUSED OR NECESSITATED BY ACTS OF THE LOT OR RESERVE AREA OWNER OR SAID OWNER'S AGENTS OR CONTRACTORS. SAID RESTRICTIONS ON ALTERATIONS OF GRADE AND LIMITATIONS ON CONSTRUCTION ACTIVITIES SHALL BE LIMITED TO UTILITY EASEMENTS AND DO NOT APPLY TO AREAS OUTSIDE OF THE UTILITY EASEMENTS DESIGNATED ON THE PLAT.

5. THE FOREGOING COVENANTS SET FORTH IN THIS SUBSECTION B. CONCERNING ELECTRIC, COMMUNICATION, AND GAS SERVICES SHALL BE ENFORCEABLE BY EACH SUPPLIER OF THE ELECTRIC, COMMUNICATION, AND GAS SERVICE AND EACH LOT OR RESERVE AREA OWNER AGREES TO BE BOUND HEREBY.

C. WATER, SANITARY SEWER, AND STORM SEWER SERVICES:

1. EACH LOT AND RESERVE AREA OWNER SHALL BE RESPONSIBLE FOR THE PROTECTION OF THE PUBLIC WATER MAINS, SANITARY SEWER MAINS, AND STORM SEWER FACILITIES LOCATED ON SUCH OWNER'S LOT OR RESERVE AREA.

2. WITHIN THE UTILITY EASEMENT AREAS DEPICTED ON THE ACCOMPANYING PLAT, THE ALTERATION OF GRADE IN EXCESS OF THREE (3) FEET FROM THE CONTOURS EXISTING UPON THE COMPLETION OF THE INSTALLATION OF A PUBLIC WATER MAIN, SANITARY SEWER MAIN, OR STORM SEWER, OR ANY CONSTRUCTION ACTIVITY WHICH WOULD, IN THE JUDGMENT OF THE CITY OF BROKEN ARROW, INTERFERE WITH PUBLIC WATER MAINS, SANITARY SEWER MAINS, OR STORM SEWERS, SHALL BE PROHIBITED.

3. THE CITY OF BROKEN ARROW, OKLAHOMA, OR ITS SUCCESSORS, SHALL BE RESPONSIBLE FOR THE ORDINARY MAINTENANCE OF PUBLIC WATER MAINS, SANITARY SEWER MAINS, AND STORM SEWERS, BUT THE LOT OR RESERVE AREA OWNER SHALL PAY FOR DAMAGE OR RELOCATION OF SUCH FACILITIES CAUSED OR NECESSITATED BY ACTS SUCH OWNER OR SUCH OWNER'S AGENTS OR CONTRACTORS.

4. THE CITY OF BROKEN ARROW, OKLAHOMA, OR ITS SUCCESSORS, SHALL AT ALL TIMES HAVE RIGHT OF ACCESS TO ALL UTILITY EASEMENTS DEPICTED ON THE ACCOMPANYING PLAT, OR OTHERWISE PROVIDED FOR IN THIS DEED OF DEDICATION, FOR THE PURPOSE OF INSTALLING, MAINTAINING, REMOVING, OR REPLACING ANY PORTION OF UNDERGROUND WATER, SANITARY SEWER, OR STORM SEWER FACILITIES.

5. THE FOREGOING COVENANTS SET FORTH IN THIS SUBSECTION C. SHALL BE ENFORCEABLE BY THE CITY OF BROKEN ARROW, OKLAHOMA, OR ITS SUCCESSORS, AND THE OWNER AND OWNERS OF EACH LOT AND RESERVE AREA AGREE TO BE BOUND HEREBY.

D. SURFACE DRAINAGE:

EACH LOT SHALL RECEIVE AND DRAIN, IN AN UNOBSTRUCTED MANNER, THE STORM AND SURFACE WATERS FROM LOTS, RESERVE AREAS, AND DRAINAGE AREAS OF HIGHER ELEVATION AND FROM PUBLIC STREETS AND EASEMENTS. NO LOT OWNER SHALL CONSTRUCT OR PERMIT TO BE CONSTRUCTED ANY FENCING OR OTHER OBSTRUCTIONS WHICH WOULD IMPAIR THE DRAINAGE OF STORM OR SURFACE WATERS OVER AND ACROSS SUCH OWNER'S LOT. THE FOREGOING COVENANTS SET FORTH IN THIS SUBSECTION D. SHALL BE ENFORCEABLE BY ANY AFFECTED LOT OR RESERVE AREA OWNER AND BY THE HOA. NO LOT OR RESERVE AREA OWNER SHALL ALLOW OR CONTRIBUTE TO THE DEGRADATION OF GROUND OR SURFACE WATER ON OR ACROSS SUCH OWNER'S LOT OR RESERVE AREA IN VIOLATION OF ENVIRONMENTAL REGULATIONS OF THE UNITED STATES OR THE STATE OF OKLAHOMA.

E. PAVING AND LANDSCAPING WITHIN EASEMENTS:

THE OWNER OF THE LOT OR RESERVE AREA AFFECTED SHALL BE RESPONSIBLE FOR THE REPAIR OF DAMAGE TO LANDSCAPING OR PAVING OCCASIONED BY INSTALLATION OR NECESSARY MAINTENANCE OF UNDERGROUND WATER, SANITARY SEWER, STORM SEWER, NATURAL GAS,

COMMUNICATION, OR ELECTRIC FACILITIES WITHIN THE UTILITY EASEMENT AREAS DEPICTED UPON THE ACCOMPANYING PLAT, PROVIDED, HOWEVER, THE CITY OF BROKEN ARROW, OKLAHOMA, OR THE SUPPLIER OF THE UTILITY SERVICE, SHALL USE REASONABLE CARE IN THE PERFORMANCE OF SUCH ACTIVITIES.

F. OTHER USES:

ALL LOT AND RESERVE AREA OWNERS HAVE THE RIGHT TO USE THE EASEMENT AREAS SITUATED WITHIN SUCH OWNER'S LOT OR RESERVE AREA IN ANY MANNER THAT WILL NOT PREVENT OR INTERFERE WITH THE EXERCISE BY THE CITY OF BROKEN ARROW OR THE PROVIDER OF UTILITY SERVICE OF THE EASEMENT RIGHTS GRANTED UNDER THIS DEDICATION.

G. ACCESS RESTRICTIONS:

1. THE UNDERSIGNED OWNER HEREBY RELINQUISHES RIGHTS OF VEHICULAR INGRESS OR EGRESS FROM ANY PORTION OF THE PROPERTY ADJACENT TO EAST TUCSON STREET WITHIN THE BOUNDS DESIGNATED AS "LIMITS OF NO ACCESS" OR "LNA" ON THE ACCOMPANYING PLAT, WHICH "LIMITS OF NO ACCESS" MAY BE AMENDED OR RELEASED BY THE BROKEN ARROW PLANNING COMMISSION, OR ITS SUCCESSOR, AND WITH THE APPROVAL OF THE CITY OF BROKEN ARROW, OKLAHOMA, OR AS OTHERWISE PROVIDED BY THE STATUTES AND LAWS OF THE STATE OF OKLAHOMA PERTAINING THERETO, AND THE LIMITS OF NO ACCESS ABOVE ESTABLISHED SHALL BE ENFORCEABLE BY THE CITY OF BROKEN ARROW, OKLAHOMA.

2. ACCESS IS RESTRICTED AND ADDITIONAL SETBACK AND OTHER CITY OF BROKEN ARROW ZONING ORDINANCE RESTRICTIONS APPLY TO LOTS WITH LOT LINES DESIGNATED "RESTRICTED ACCESS" OR "R.A."

H. SIDEWALKS:

SIDEWALKS SHALL BE CONSTRUCTED BY EACH PROPERTY OWNER IN COMPLIANCE WITH THE ENGINEERING DESIGN STANDARDS OF THE CITY OF BROKEN ARROW. SIDEWALKS WILL BE CONSTRUCTED BY THE OWNER ALONG ALL STREETS ADJACENT TO ALL RESERVE AREAS.

I. FENCE AND LANDSCAPE EASEMENTS:

THE OWNER DOES HEREBY ESTABLISH AND GRANT, TO THE OWNERS OF THE RESIDENTIAL LOTS WITHIN THE SUBDIVISION, AND TO THE HOA AS HEREIN SET FORTH WITHIN SECTION V., AND FOR THEIR COMMON USE AND BENEFIT, FENCE AND LANDSCAPE EASEMENTS OVER AND UPON THE AREAS DESIGNATED AS "FENCE & LANDSCAPE EASEMENT" OR "F/E" AND SHOWN ON THE ACCOMPANYING PLAT. THE FENCE AND LANDSCAPE EASEMENTS ARE FOR THE LIMITED PURPOSE OF CONSTRUCTING AND MAINTAINING PERIMETER DECORATIVE FENCES AND ENTRY FEATURES INCLUDING BUT NOT LIMITED TO SIGNAGE, FENCES, WALLS, SPRINKLER SYSTEMS, LANDSCAPING, AND LIGHTING, AND FOR THE MAINTENANCE AND REPAIR THEREOF, TOGETHER WITH THE RIGHT OF ACCESS OVER, ACROSS, AND ALONG SUCH EASEMENTS AND OVER, ACROSS, AND ALONG ALL AREAS WHICH CONTAIN SUCH EASEMENTS. WITHIN THE FENCE AND LANDSCAPE EASEMENTS, THE HOA SHALL BE RESPONSIBLE FOR MAINTENANCE OF ALL FENCES AND WALLS AND ENTRY FEATURES AND ALL LANDSCAPING LOCATED OUTSIDE OF SUCH FENCES AND WALLS. THE RIGHTS HEREIN ESTABLISHED AND GRANTED SHALL BE SUBORDINATE TO THE RIGHTS ESTABLISHED AND GRANTED BY UTILITY EASEMENTS ELSEWHERE DEDICATED HEREIN.

J. RETAINING WALL EASEMENTS:

THE OWNER DOES HEREBY ESTABLISH, AND RESERVE FOR FUTURE GRANT AND CONVEYANCE TO THE HOA AS SET FORTH WITHIN SECTION V. HEREIN, PERPETUAL, NON-EXCLUSIVE EASEMENTS OVER AND UPON THE AREAS DESIGNATED AS "RETAINING WALL EASEMENT" OR "RWE" ON THE ACCOMPANYING PLAT FOR THE USE AND BENEFIT OF THE CITY OF BROKEN ARROW, OKLAHOMA, THE OWNERS OF LOTS WITHIN THE SUBDIVISION, AND THE HOA. THE RETAINING WALL EASEMENTS ARE FOR THE LIMITED PURPOSE OF CONSTRUCTING AND MAINTAINING RETAINING WALLS, SOMETIMES TOGETHER WITH PRIVACY WALLS AND/OR FENCES, AND THE MAINTENANCE AND REPAIR THEREOF, TOGETHER WITH THE RIGHT OF ACCESS, INGRESS, AND EGRESS OVER, ACROSS, AND ALONG ADJACENT LANDS WITHIN THE LOTS CONTAINING SUCH EASEMENTS FOR THE PURPOSES FOR WHICH THE ABOVE-MENTIONED RIGHTS ARE GRANTED. WITHIN THE RETAINING WALL EASEMENT AREAS, THE HOA SHALL BE RESPONSIBLE FOR MAINTENANCE AND REPAIR OF ALL WALLS AND FENCES, ANY PRIVACY FENCES OR WALLS WITHIN THE EASEMENTS, ADJACENT TO OR INTEGRATED WITH A RETAINING WALL, SHALL BE SUBJECT TO THE REVIEW AND APPROVAL OF THE ENGINEERING DEPARTMENT OF THE CITY OF BROKEN ARROW, OKLAHOMA. THE RIGHTS HEREIN ESTABLISHED AND GRANTED SHALL BE SUBORDINATE TO THE RIGHTS ESTABLISHED AND GRANTED BY UTILITY EASEMENTS ELSEWHERE DEDICATED HEREIN.

K. STORMWATER DRAINAGE AND DETENTION EASEMENT:

1. THE OWNER DOES HEREBY DEDICATE TO THE CITY OF BROKEN ARROW, OKLAHOMA, ITS SUCCESSORS AND ASSIGNS, PERPETUAL, NON-EXCLUSIVE EASEMENTS ON, OVER, AND ACROSS THE PROPERTY DESIGNATED AND SHOWN ON THE ACCOMPANYING PLAT AS "STORMWATER DRAINAGE AND DETENTION EASEMENT" FOR THE PURPOSES OF PERMITTING THE OVERLAND AND UNDERGROUND FLOW, CONVEYANCE, DETENTION, RETENTION, AND DISCHARGE OF STORMWATER RUNOFF FROM THE VARIOUS LOTS AND RESERVE AREAS WITHIN THE SUBDIVISION AND FROM PROPERTIES NOT INCLUDED WITHIN THE SUBDIVISION.

2. STORMWATER DETENTION, RETENTION, AND DRAINAGE FACILITIES LOCATED WITHIN THE STORMWATER DRAINAGE AND DETENTION EASEMENTS SHALL BE CONSTRUCTED IN ACCORDANCE WITH STANDARDS AND SPECIFICATIONS APPROVED BY THE CITY OF BROKEN ARROW, OKLAHOMA.

3. EXCEPT AS SPECIFICALLY PROVIDED HEREIN, NO FENCE, WALL, BUILDING, OR OTHER OBSTRUCTION SHALL BE PLACED OR MAINTAINED IN THE STORMWATER DRAINAGE AND DETENTION EASEMENT AREAS, NOR SHALL THERE BE ANY ALTERATION OF GRADE IN SAID EASEMENT AREAS UNLESS APPROVED BY THE CITY OF BROKEN ARROW, OKLAHOMA; PROVIDED, HOWEVER, THAT THE PLANTING OF TURF OR OTHER LANDSCAPING (EXCEPTING TREES AND SHRUBS) SHALL NOT REQUIRE THE APPROVAL OF THE CITY OF BROKEN ARROW. FENCES, WALLS, AND LANDSCAPING TREES OR SHRUBS INSTALLED BY THE OWNER OR BY THE HOA, WITH THE APPROVAL OF THE CITY OF BROKEN ARROW, SHALL BE PERMITTED, PROVIDED THAT THE SAME DO NOT CAUSE OBSTRUCTION OF THE FLOW, CONVEYANCE, DETENTION, RETENTION, OR DISCHARGE OF STORMWATER THROUGH THE EASEMENT AREAS.

4. STORMWATER DRAINAGE, DETENTION, AND RETENTION FACILITIES SHALL BE MAINTAINED BY THE OWNER OF THE LOT OR RESERVE AREA SUBJECT TO THE STORMWATER DRAINAGE AND

DETENTION EASEMENT TO THE EXTENT NECESSARY TO ACHIEVE THE INTENDED STORMWATER DRAINAGE, DETENTION, AND RETENTION FUNCTIONS, INCLUDING REPAIR OF APPURTENANCES AND REMOVAL OF OBSTRUCTIONS AND SILTATION, AND SUCH OWNER SHALL PROVIDE CUSTOMARY GROUNDS MAINTENANCE WITHIN THE EASEMENT AREA IN ACCORDANCE WITH THE FOLLOWING MINIMUM STANDARDS:

- A. GRASS AREAS SHALL BE MOWED (IN SEASON) AT REGULAR INTERVALS OF FOUR (4) WEEKS, OR LESS.
- B. CONCRETE APPURTENANCES SHALL BE MAINTAINED IN GOOD CONDITION AND REPLACED IF DAMAGED.
- C. THE EASEMENT AREAS SHALL BE KEPT FREE OF DEBRIS.
- D. CLEANING OF SILTATION AND VEGETATION FROM CONCRETE CHANNELS SHALL BE PERFORMED TWICE YEARLY.

5. IN THE EVENT THE OWNER OF THE LOT OR RESERVE AREA SUBJECT TO THE STORMWATER DRAINAGE AND DETENTION EASEMENT SHOULD FAIL TO PROPERLY MAINTAIN THE DETENTION, RETENTION, OR OTHER DRAINAGE FACILITIES OR, IN THE EVENT OF THE PLACEMENT OF AN OBSTRUCTION WITHIN, OR THE ALTERATION OF GRADE WITHIN THE EASEMENT AREA, THE CITY OF BROKEN ARROW, OKLAHOMA, OR ITS DESIGNATED CONTRACTOR, MAY ENTER THE EASEMENT AREA AND PERFORM MAINTENANCE NECESSARY TO ACHIEVE THE INTENDED DRAINAGE, DETENTION, OR RETENTION FUNCTIONS AND MAY REMOVE ANY OBSTRUCTION OR SILTATION OR CORRECT ANY ALTERATION OF GRADE, AND THE COSTS THEREOF SHALL BE PAID BY THE OWNER OF THE LOT OR RESERVE AREA SUBJECT TO THE EASEMENT, WHICH SHALL BE THE HOA UPON CONVEYANCE THE LOT OR RESERVE AREA CONTAINING THE EASEMENT AREA TO THE ASSOCIATION, IN THE EVENT THE OWNER OF THE LOT OR RESERVE AREA SUBJECT TO THE EASEMENT SHOULD FAIL TO PAY THE COSTS OF MAINTENANCE, AFTER COMPLETION OF THE MAINTENANCE AND RECEIPT OF A STATEMENT OF COSTS, THE CITY OF BROKEN ARROW, OKLAHOMA, MAY FILE OF RECORD A COPY OF THE STATEMENT OF COSTS IN THE RECORDS OF THE TULSA COUNTY CLERK, AND THEREAFTER THE COSTS SHALL BE A LIEN AGAINST THE OWNER OF THE LOT OR RESERVE AREA SUBJECT TO THE EASEMENT. A LIEN ESTABLISHED AS ABOVE PROVIDED MAY BE FORECLOSED BY THE CITY OF BROKEN ARROW, OKLAHOMA.

SECTION II. RESERVE AREAS

J. ALL RESERVE AREAS:

1. ALL RESERVE AREAS ARE HEREBY ESTABLISHED FOR THE COMMON USE AND BENEFIT OF THE OWNERS OF LOTS WITHIN THE SUBDIVISION AND ARE RESERVED FOR SUBSEQUENT CONVEYANCE TO THE HOMEOWNERS' ASSOCIATION ("HOA" OR "ASSOCIATION") DEFINED IN SECTION V.

2. ALL COSTS AND EXPENSES ASSOCIATED WITH ALL RESERVE AREAS, INCLUDING MAINTENANCE OF VARIOUS IMPROVEMENTS AND RECREATIONAL FACILITIES, SHALL BE THE RESPONSIBILITY OF THE OWNER THEREOF, WHICH OWNER SHALL BE THE HOA UPON CONVEYANCE OF SAME BY OWNER TO THE ASSOCIATION. SEE SECTION V. FOR ADDITIONAL DETAILS AND REQUIREMENTS.

3. THE CITY OF BROKEN ARROW, OKLAHOMA, SHALL NOT BE LIABLE FOR ANY DAMAGE OR REMOVAL OF ANY LANDSCAPING OR IRRIGATION SYSTEMS IN ANY RESERVE AREA.

4. IN THE EVENT ANY RESERVE AREA OWNER SHOULD FAIL TO MAINTAIN THE RESERVE AREA, THE CITY OF BROKEN ARROW, OKLAHOMA, OR ITS DESIGNATED CONTRACTOR, MAY ENTER THE RESERVE AREA AND PERFORM SUCH MAINTENANCE AS NECESSARY TO ACHIEVE ITS INTENDED FUNCTIONS, AND THE COSTS THEREOF SHALL BE PAID BY THE OWNER OF THE RESERVE AREA. IN THE EVENT THE RESERVE AREA OWNER SHOULD THEN FAIL TO PAY THE COSTS OF SAID MAINTENANCE, AFTER COMPLETION OF THE MAINTENANCE BY THE CITY OF BROKEN ARROW, OKLAHOMA, OR ITS DESIGNATED CONTRACTOR, AND PROVISION OF A STATEMENT OF COSTS FROM THE CITY TO THE RESERVE AREA OWNER, THE CITY OF BROKEN ARROW, OKLAHOMA, MAY FILE OF RECORD A COPY OF THE STATEMENT OF COSTS, AND THEREAFTER THE COSTS SHALL BE A LIEN AGAINST SUCH RESERVE AREA, WHICH LIEN MAY BE FORECLOSED BY THE CITY OF BROKEN ARROW, OKLAHOMA.

5. EACH LOT OWNER AND RESIDENT AND MEMBER OF THE HOA SHALL INDEMNIFY AND HOLD HARMLESS THE OWNER AND THE CITY OF BROKEN ARROW, AND THEIR RESPECTIVE AGENTS AND REPRESENTATIVES, FROM ALL CLAIMS, DEMANDS, LIABILITIES, OR DAMAGES ARISING IN CONNECTION WITH THE OWNERSHIP OR USE OF THE FACILITIES AND IMPROVEMENTS CONSTRUCTED OR SITUATED WITHIN THE RESERVE AREAS AND FURTHER AGREES THAT NEITHER THE OWNER NOR CITY OF BROKEN ARROW SHALL BE LIABLE TO ANY LOT OR RESERVE AREA OWNER OR RESIDENT OR MEMBER OF THE ASSOCIATION OR ANY GUEST, VISITOR, OR INVITEE THEREOF FOR ANY DAMAGE TO PERSON OR PROPERTY CAUSED BY ACTION, OMISSION, OR NEGLIGENCE OF A LOT OR RESERVE AREA OWNER OR RESIDENT OR MEMBER OF THE ASSOCIATION OR ANY GUEST, VISITOR, OR INVITEE THEREOF.

B. RESERVE AREAS A, B, AND C:

1. RESERVES A, B, AND C ARE DESIGNATED TO BE USED FOR OVERLAND AND UNDERGROUND STORMWATER DRAINAGE AND DETENTION, NEIGHBORHOOD AMENITIES, OPEN SPACE, SIDEWALKS, LANDSCAPING, IRRIGATION, LIGHTING, SIGNAGE, RETAINING WALLS, AND OTHER USES AS MAY BE PERMITTED BY THE CITY OF BROKEN ARROW, OKLAHOMA.

SECTION III. PLANNED UNIT DEVELOPMENT RESTRICTIONS

WHEREAS, 'SPRING CREEK CROSSING' WAS SUBMITTED AS PART OF A PLANNED UNIT DEVELOPMENT (DESIGNATED AS PUD-001360-2024) AS PROVIDED WITHIN THE PUD PROVISIONS OF THE ZONING ORDINANCE OF THE CITY OF BROKEN ARROW, OKLAHOMA, AS THE SAME EXISTED ON APRIL 16, 2024; AND

WHEREAS, PUD-001360-2024 WAS AFFIRMATIVELY RECOMMENDED BY THE PLANNING COMMISSION OF THE CITY OF BROKEN ARROW ON MARCH 28, 2024 AND APPROVED BY THE COUNCIL OF THE CITY OF BROKEN ARROW ON APRIL 16, 2024; AND

WHEREAS, THE PLANNED UNIT DEVELOPMENT PROVISIONS OF THE BROKEN ARROW ZONING ORDINANCE REQUIRE THE ESTABLISHMENT OF COVENANTS OF RECORD, INURING TO AND ENFORCEABLE BY THE CITY OF BROKEN ARROW, SUFFICIENT TO INSURE THE IMPLEMENTATION AND CONTINUED COMPLIANCE WITH THE APPROVED PLANNED UNIT DEVELOPMENT; AND

WHEREAS, THE OWNER DESIRES TO ESTABLISH COVENANTS OF RECORD FOR THE PURPOSE OF PROVIDING FOR AN ORDERLY DEVELOPMENT AND TO INSURE ADEQUATE COMPLIANCE WITH PUD-001360-2024 FOR THE MUTUAL BENEFIT OF THE OWNER, ITS SUCCESSORS AND ASSIGNS, AND THE CITY OF BROKEN ARROW.

NOW, THEREFORE, THE OWNER DOES HEREBY IMPOSE THE FOLLOWING RESTRICTIONS AND COVENANTS WHICH SHALL BE COVENANTS RUNNING WITH THE LAND AND SHALL BE BINDING UPON THE OWNER, ITS SUCCESSORS AND ASSIGNS, AND SHALL BE ENFORCEABLE AS HEREINAFTER SET FORTH.

A. DEVELOPMENT IN ACCORDANCE WITH PLANNED UNIT DEVELOPMENT:

PUD-001360-2024 WILL BE DEVELOPED IN ACCORDANCE WITH THE BROKEN ARROW ZONING ORDINANCE (THE "ZONING ORDINANCE") AND THE USE AND DEVELOPMENT REGULATIONS OF THE RS-4 SINGLE FAMILY RESIDENTIAL-4 DISTRICT, AS THE SAME EXISTED ON APRIL 16, 2024, EXCEPT AS NOTED HEREIN.

B. DEVELOPMENT STANDARDS:

1. GROSS LAND AREA:	1,690,585 SF	38.810 AC
2. NET LAND AREA:	1,611,344 SF	36.991 AC
3. PERMITTED USES:	SINGLE-FAMILY DETACHED DWELLINGS; NEIGHBORHOOD COMMUNITY PLAYFIELDS AND PARKS INCLUDING CLUBHOUSES, POOLS, AND SIMILAR NEIGHBORHOOD AMENITIES, MINOR UTILITY FACILITIES, AND USES CUSTOMARILY ACCESSORY TO USES PERMITTED HEREIN.	
4. MAXIMUM NUMBER OF LOTS:		145
5. MINIMUM LOT WIDTH:		50 FT
6. MINIMUM LOT AREA:		5,000 SF
7. MINIMUM LAND AREA PER DWELLING UNIT:		7,000 SF *
8. MAXIMUM BUILDING HEIGHT:		35 FT **
9. MINIMUM OFF-STREET PARKING:		TWO (2) PER DWELLING UNIT
10. MAXIMUM LOT COVERAGE:		55% INTERIOR LOTS; 65% CORNER LOTS ***
11. MINIMUM LIVABILITY OPEN SPACE PER DWELLING		2,800 SF***
12. MINIMUM YARD SETBACKS:		
FRONT YARD:		20 FT
REAR YARD:		20 FT
SIDE YARD (ONE, TOTAL):		5 FT, 10 FT
SIDE YARD ADJACENT TO ARTERIAL STREET:		35 FT
SIDE YARD ADJACENT TO NON-ARTERIAL STREET/ALLEY:		20 FT
ANY YARD WITHIN 35 FT OF ARTERIAL STREET:		35 FT FROM ARTERIAL STREET RIGHT-OF-WAY
13. OTHER BULK AND AREA REQUIREMENTS:		AS REQUIRED WITHIN THE RS-4 DISTRICT (TO BE RS-C)

* MINIMUM LAND AREA PER DWELLING UNIT IS SATISFIED BY THE PROPORTION OF MAXIMUM NUMBER OF DWELLING UNITS TO GROSS LAND AREA AS PROVIDED IN SECTION 4.1.E.1.B. OF THE BROKEN ARROW ZONING ORDINANCE. LOTS ARE THEREFORE NOT SUBJECT TO THIS REQUIREMENT ON AN INDIVIDUAL BASIS.

** ARCHITECTURAL FEATURES MAY EXTEND A MAX. OF FIVE (5) FEET ABOVE MAXIMUM PERMITTED BUILDING HEIGHT.

*** MAXIMUM AGGREGATE LOT COVERAGE BY BUILDINGS, PARKING, AND DRIVES IS LIMITED TO THE LESSER OF THE SPECIFIED PERCENTAGE OR THAT AMOUNT NECESSARY TO MEET MINIMUM LIVABILITY OPEN SPACE REQUIREMENTS FOR THE LOT. LIVABILITY OPEN SPACE, DEFINED AS OPEN SPACE NOT UTILIZED FOR PARKING OR DRIVES, MAY BE LOCATED ON A LOT OR CONTAINED WITHIN COMMON OPEN SPACE OF THE DEVELOPMENT, AS PER SECTION 4.1.E.1.D. OF THE BROKEN ARROW ZONING ORDINANCE. REQUIREMENTS FOR COMMON OPEN SPACE ARE PROVIDED IN SECTION IV.F. OF THIS PUD.

P06: Please remove

Conditional Final Plat

PUD-001360-2024

Spring Creek Crossing

PART OF THE SOUTHWEST QUARTER OF THE SOUTHEAST QUARTER (SW/4 SE/4) OF SECTION THIRTY-FIVE (35),
TOWNSHIP EIGHTEEN (18) NORTH, RANGE FOURTEEN (14) EAST OF THE INDIAN MERIDIAN
A SUBDIVISION WITHIN THE CITY OF BROKEN ARROW, TULSA COUNTY, STATE OF OKLAHOMA

P07: Use the current zoning and PUD

DEED OF DEDICATION AND RESTRICTIVE COVENANTS (CONTINUED)

SECTION III. PLANNED UNIT DEVELOPMENT RESTRICTIONS (CONTINUED)

C. GENERAL PROVISIONS AND DEVELOPMENT STANDARDS:

1. ACCESS AND CIRCULATION:
ALL STREETS SHALL BE CONSTRUCTED TO MEET THE CITY OF BROKEN ARROW STANDARDS FOR PUBLIC STREETS.

SIDEWALKS AND/OR TRAILS SHALL BE CONSTRUCTED AS REQUIRED AND WILL BE PLANNED DURING THE ENGINEERING DESIGN AND PLATTING PHASE.

LIMITS OF NO ACCESS (LNA) WILL BE IMPOSED BY THE FUTURE PLAT(S) ALONG THE EAST TUCSON STREET FRONTAGE, EXCEPT AT APPROVED STREET INTERSECTION(S).

THE DEVELOPER COMMITS TO INCLUDING A TRAFFIC SIGNAL ON E. TUCSON ST. AS PART OF THIS DEVELOPMENT. THE EXACT LOCATION, DESIGN, AND TIMELINE FOR INSTALLATION OF THE TRAFFIC SIGNAL IS SUBJECT TO COORDINATION, REVIEW, AND APPROVAL BY THE CITY OF BROKEN ARROW.

2. SIGNAGE, LANDSCAPING, AND FENCING:
SIGNS, LANDSCAPING, AND FENCING SHALL COMPLY WITH THE APPLICABLE PROVISIONS OF THE BROKEN ARROW ZONING ORDINANCE.

IN ACCORDANCE WITH PROPOSED RS-C ZONING, 50-FOOT MINIMUM WIDTH OPEN SPACE BUFFERS SHALL BE PRESERVED ALONG THE WEST AND EAST LINES OF THE PUD ADJACENT TO EXISTING PLATTED RESIDENTIAL LOTS, WHICH AREAS SHALL BE MAINTAINED BY A MANDATORY PROPERTY OWNERS' ASSOCIATION. WITHIN THE REQUIRED 50'-MINIMUM-WIDTH OPEN SPACE PRESERVE AREAS, ANY TREE WITH A MINIMUM OF 6 INCHES IN CALIPER EXISTING WITHIN THE PUD AT THE TIME OF APPROVAL SHALL BE PRESERVED, OTHER THAN REMOVAL AS NEEDED FOR UTILITY INSTALLATION OR DRAINAGE PURPOSES.

3. UTILITIES AND DRAINAGE:
WATERLINES SHALL BE EXTENDED THROUGHOUT THE SITE AND LOOPED TO PROVIDE WATER SERVICE AND FIRE PROTECTION AND WILL BE DESIGNED DURING THE PLATTING STAGE. FIRE HYDRANT LOCATIONS SHALL BE COORDINATED WITH AND APPROVED BY THE BROKEN ARROW FIRE MARSHAL DURING PLATTING.

4. PLATTING AND SITE PLAN REQUIREMENTS:
NO BUILDING PERMIT SHALL BE ISSUED UNTIL A SUBDIVISION PLAT HAS BEEN SUBMITTED TO AND RECOMMENDED UPON BY THE BROKEN ARROW PLANNING COMMISSION AND APPROVED BY THE COUNCIL OF THE CITY OF BROKEN ARROW, AND DULY FILED OF RECORD. THE REQUIRED SUBDIVISION PLAT SHALL INCLUDE COVENANTS OF RECORD IMPLEMENTING THE DEVELOPMENT STANDARDS OF THE APPROVED PUD AND THE CITY OF BROKEN ARROW SHALL BE A BENEFICIARY THEREOF. THE PLAT WILL ALSO SERVE AS THE SITE PLAN FOR ALL RESIDENTIAL LOTS CONTAINED WITHIN THE PLAT. ANY NEIGHBORHOOD AMENITIES REQUIRING A BUILDING PERMIT SHALL SUBMIT AND RECEIVE BROKEN ARROW CITY STAFF APPROVAL OF A SITE PLAN APPLICATION.

NOT LESS THAN 15% OF THE NET LAND AREA SHALL BE PRESERVED AS COMMON OPEN SPACE FOR THE ENJOYMENT OF THE RESIDENTS, AND NOT LESS THAN 25% OF THE REQUIRED AREA SHALL BE DESIGNED, CONSTRUCTED, AND MAINTAINED AS ACTIVE OPEN SPACE CONSISTING OF TRAILS, COMMUNITY GARDENS, AND/OR PARKS.

SECTION IV. RESTRICTIVE COVENANTS

THE SUBDIVISION (AND EACH LOT SITUATED THEREIN) SHALL BE CONSTRUCTED, DEVELOPED, OCCUPIED AND USED AS FOLLOWS.

B. NO DIVISION OF LOTS:

NO LOT MAY BE DIVIDED OR SPLIT.

C. RESIDENTIAL LOTS:

ALL LOTS WITHIN THE SUBDIVISION SHALL BE USED, KNOWN AND DESCRIBED AS RESIDENTIAL LOTS. ONLY ONE SINGLE FAMILY RESIDENTIAL DWELLING SHALL BE PERMITTED ON EACH LOT. IN ADDITION, ONLY CUSTOMARY AND USUAL NECESSARY STRUCTURES MAY BE CONSTRUCTED ON EACH LOT AS MAY BE PERMITTED BY THE CITY. NO BUILDING OR STRUCTURE INTENDED FOR OR ADAPTED TO BUSINESS PURPOSES SHALL BE ERCTED, PLACED, PERMITTED OR MAINTAINED ON ANY LOT. THIS COVENANT SHALL BE CONSTRUED AS PROHIBITING THE ENGAGING IN OR PRACTICE OF ANY COMMERCE, INDUSTRY, BUSINESS, TRADE OR PROFESSION WITHIN THE SUBDIVISION AND/OR WITHIN ANY LOT. THE RESTRICTIONS ON USE HEREIN CONTAINED SHALL BE CUMULATIVE OF AND IN ADDITION TO SUCH RESTRICTIONS ON USAGE AS MAY FROM TIME TO TIME BE APPLICABLE UNDER AND PURSUANT TO THE STATUTES, RULES, REGULATIONS AND ORDINANCES OF THE CITY OR ANY OTHER GOVERNMENTAL AUTHORITY OR POLITICAL SUBDIVISION HAVING JURISDICTION OVER THE SUBDIVISION.

D. RESIDENTIAL PURPOSES:

BY ACQUISITION OF ANY LOT WITHIN THE SUBDIVISION, EACH OWNER (EXCLUDING BONA FIDE HOME BUILDERS) COVENANTS WITH AND REPRESENTS TO THE DECLARANT AND TO THE ASSOCIATION THAT THE LOT IS BEING SPECIFICALLY ACQUIRED FOR THE SPECIFIC AND SINGULAR PURPOSE OF CONSTRUCTING AND USING A SINGLE FAMILY RESIDENTIAL DWELLING THEREON, OR AS A RESIDENCE FOR SUCH OWNER AND/OR OWNER'S IMMEDIATE FAMILY MEMBERS.

E. SUBMISSION OF PLANS:

IN ORDER TO MAINTAIN A BEAUTIFUL AND PLEASING SETTING IN THE SUBDIVISION, TWO (2) SETS OF BUILDING AND SITE IMPROVEMENT PLANS AND SPECIFICATIONS MUST BE SUBMITTED TO THE ARCHITECTURAL CONTROL COMMITTEE ("COMMITTEE") FOR ITS APPROVAL PRIOR TO THE COMMENCEMENT OF CONSTRUCTION. THE COMMITTEE SHALL ACT TO ENFORCE THE REQUIREMENTS OF THESE COVENANTS IN A REASONABLE MANNER. THE COMMITTEE HAS THE AUTHORITY TO MAINTAIN THE ARCHITECTURAL CONFORMITY OF THE SUBDIVISION, AND IN CONSIDERATION THEREOF SHALL DETERMINE THAT THE PROPOSED CONSTRUCTION SHALL NOT DETRACT FROM THE DEVELOPMENT AND SHALL ENHANCE THE PURPOSE OF THE DEVELOPMENT TO PROVIDE A BEAUTIFUL AND PLEASING SETTING IN THE SUBDIVISION. THE COMMITTEE SHALL CONSIDER SUCH MATTERS AS THE PROPOSED SQUARE FOOTAGE, LOCATION, MATERIALS, EXTERIOR STYLE AND LANDSCAPING, ETC. THE COMMITTEE MAY ADOPT RULES OR BYLAWS EXPLAINING THE MECHANICS OF ITS OPERATION AND PROVIDING FOR A TWENTY-ONE (21) DAY MAXIMUM TIME WITHIN WHICH PLANS MUST BE REVIEWED AND APPROVED OR DISAPPROVED AFTER SUBMISSION, AND IF NOT APPROVED OR DISAPPROVED IN THAT PERIOD, THAT THE SAME SHALL BE CONSIDERED AS AUTOMATICALLY APPROVED. THE BOARD MAY ALSO EXERCISE THE DUTIES OF THE COMMITTEE IN THE EVENT THE BOARD DEEMS IT NECESSARY AND EFFICIENT TO DO SO.

F. ARCHITECTURAL REQUIREMENTS:

- EACH DWELLING SHALL FRONT A DEDICATED PUBLIC STREET.
- NO BUILDING SHALL BE LOCATED CLOSER TO THE STREET THAN THE MINIMUM BUILDING OR SET-BACK LINES SHOWN ON THE RECORDED PLAT.
- ALL RESIDENCES SHALL HAVE ROOF SHINGLES THAT ARE GREY OR BLACK IN COLOR, PREFERABLY WEATHERWOOD. DEVIATION FROM THIS COLOR REQUIRES APPROVAL FROM THE COMMITTEE.

F. ADDITIONS TO EXISTING STRUCTURES:

ALL ADDITIONS SHALL CONFORM TO THE BASIC STYLING AND MATERIALS OF THE DWELLING ON ANY LOT. ALL ADDITIONS SHALL FALL WITHIN THE BUILDING SET-BACKS ON SAID LOT AND SHALL NOT BE PLACED OVER ANY DRAINAGE OR UTILITY EASEMENT. ALL IMPROVEMENTS SHALL BE CONSTRUCTED IN ACCORDANCE WITH APPLICABLE CITY CODES, RULES AND REGULATIONS. ANY ADDITIONS CONTEMPLATED BY THE HOME OWNER OR LOT OWNER MUST SUBMIT PLANS PRIOR TO CONSTRUCTION TO THE COMMITTEE FOR APPROVAL. THE COMMITTEE HAS COMPLETE AND SOLE DISCRETION TO APPROVE, MODIFY, DENY OR CHANGE ANY REQUEST FOR AN ADDITION TO AN EXISTING STRUCTURE.

G. GARAGE AND DETACHED STRUCTURES AND STORAGE BUILDINGS:

ALL RESIDENCES CONSTRUCTED IN THE SUBDIVISION SHALL HAVE A PRIVATE GARAGE TO ACCOMMODATE A MINIMUM OF ONE (1) AUTOMOBILE. NO CARPORTS ARE ALLOWED ON THE SIDE, REAR OR FRONT YARDS OF ANY LOTS. EACH GARAGE SHALL BE FULLY ENCLOSED AND CONTAIN A FULL-LENGTH OVERHEAD STYLE DOOR. ALL GARAGE DOORS ARE TO BE KEPT CLOSED WHEN NOT ENTERING OR EXITING THE GARAGE. ANY DETACHED STRUCTURE TO BE BUILT ON A LOT, SUCH AS A COVERED ENTERTAINMENT AREA, GUEST HOUSE, POOL HOUSE, STORAGE BUILDING, OR OTHER STRUCTURE, SHALL CONFORM TO THE BASIC STYLING AND MATERIALS OF THE RESIDENTIAL DWELLING. ANY DETACHED STRUCTURE CONTEMPLATED FOR CONSTRUCTION BY ANY HOME OWNER OR LOT OWNER MUST, PRIOR TO CONSTRUCTION, SUBMIT ACCEPTABLE PLANS TO THE COMMITTEE, WHICH HAS COMPLETE AND SOLE DISCRETION TO APPROVE, MODIFY, DENY OR CHANGE ANY SUCH REQUEST TO CONSTRUCT.

H. TEMPORARY STRUCTURES:

NO TRAILER, MOBILE HOME, TENT, CONSTRUCTION SHACK, OR OTHER OUTBUILDING SHALL BE ERCTED ON ANY LOT IN THE SUBDIVISION EXCEPT FOR TEMPORARY USE BY CONSTRUCTION CONTRACTORS FOR A REASONABLE PERIOD OF TIME.

I. FENCES:

NO FENCE SHALL BE CONSTRUCTED IN THE AREA BETWEEN THE FRONT BUILDING LINE OF ANY DWELLING AND THE FRONT LOT LINE OF ANY LOT. NO FENCE ON A CORNER LOT SHALL BE CONSTRUCTED BEYOND THE SIDE STREET SET-BACK LINE EXCEPT FOR THE COMMUNITY ENTRY. FURTHER, THE PLACEMENT/LOCATION OF ANY PERIMETER FENCING AROUND THE SUBDIVISION AS INITIALLY INSTALLED BY THE DECLARANT AND/OR ORIGINAL DEVELOPER MAY NOT BE ADJUSTED, RELOCATED OR MOVED WITHOUT THE PRIOR CONSENT OF THE COMMITTEE AND/OR THE BOARD. ANY PRIVACY FENCE SHALL BE CONSTRUCTED SO THAT THE FRAMING SHALL BE TOWARD THE INSIDE OF THE OWNER'S LOT. ALL FENCES MUST BE INSTALLED BY A PROFESSIONAL INSTALLER AND SHALL BE SIX FOOT (6') WOOD PRIVACY FENCING WITH VERTICAL BOARDS (NOT HORIZONTAL) AND NO CHAIN-LINK FENCES, WIRE, HOG WIRE, OR OTHER SIMILAR MATERIALS SHALL BE PERMITTED, PROVIDED THAT FENCES WITHIN AND ALONG RESERVE AREAS MAY BE ORNAMENTAL AND CONSIST OF SPLIT RAIL WITH VINYL-CLAD CHAIN-LINK, WROUGHT IRON, OR ANOTHER ORNAMENTAL STYLE APPROVED BY THE COMMITTEE. ANY PRIVACY FENCE INSTALLED ADJACENT TO SUCH ORNAMENTAL FENCE SHALL HAVE THE LAST EIGHT (8) FEET OF THE FENCE TAPER TO THE HEIGHT OF THE ORNAMENTAL FENCE. PRIOR TO INSTALLATION, THE FENCE DESIGN AND NAME OF THE INSTALLER MUST BE APPROVED BY THE COMMITTEE.

J. MAILBOXES:

ALL MAILBOXES SHALL BE APPROVED BY THE UNITED STATES POSTAL SERVICE. THE TYPE OF CONSTRUCTION SHALL BE CONSISTENT WITH THE DESIGN ESTABLISHED BY THE DEVELOPER. COMMUNITY MAILBOX IS AN APPROVED ALTERNATIVE SUBJECT TO APPROVAL OF THE UNITED STATES POSTAL SERVICE.

K. SIGNS:

NO SIGN OF ANY KIND SHALL BE DISPLAYED TO THE PUBLIC VIEW ON ANY LOT EXCEPT ONE PROFESSIONAL SIGN ADVERTISING THE PROPERTY FOR SALE, REALE OR RENT, OR SIGNS USED BY BUILDER OR AGENT TO ADVERTISE THE PROPERTY DURING THE CONSTRUCTION AND SALE OF A DWELLING THEREON. IN NO EVENT SHALL ANY SUCH SIGN STAND MORE THAN SEVEN (7) FEET ABOVE GROUND LEVEL, NOR BE MORE THAN FIVE (5) SQUARE FEET IN SIZE, NOR BE LIGHTED AT NIGHT. THESE SIGNAGE RESTRICTIONS AND REQUIREMENTS SHALL NOT APPLY TO DECLARANT.

L. PARKED VEHICLES:

ALL VEHICLES PARKED IN THE FRONT OF THE FRONT BUILDING LINE MUST BE PARKED ON THE DRIVEWAY. NO INOPERATIVE VEHICLES OF ANY NATURE SHALL BE PERMITTED TO REMAIN ON ANY LOT OR LOTS FOR A PERIOD IN EXCESS OF ONE (1) DAY. IT IS THE INTENTION OF THE DECLARANT THAT, EXCEPT ON SPECIAL OCCASIONS SUCH AS HOLIDAYS OR EVENTS AT AN OWNER'S RESIDENCE THAT ALL PARKING SHALL BE IN DRIVEWAYS AND NOT ON A STREET OR ON ANY YARD. ACCORDINGLY, NO VEHICLE SHALL BE PARKED ON THE STREET FOR MORE THAN TWO (2) CONSECUTIVE DAYS AND SHALL NOT BE PARKED OVERNIGHT ON A STREET. ANY VIOLATION OF THIS SUBSECTION L. MAY RESULT IN A TOWING OF THE VEHICLE AT THE OWNER'S EXPENSE PER MUNICIPAL REGULATIONS. NO VEHICLE MAINTENANCE SHALL BE PERFORMED ON THE STREETS OR IN THE FRONT YARDS OR ON PARKING PADS OF ANY LOT.

M. APPEARANCE OF LOT:

ALL OWNERS SHALL BE REQUIRED TO KEEP THEIR LOT IN A CLEAN AND SANITARY CONDITION WHETHER OR NOT THEY HAVE CONSTRUCTED A RESIDENCE ON THE LOT. ALL OPEN AREAS ON LOTS SHALL BE KEPT MOVED TO A HEIGHT OF NOT MORE THAN SIX (6) INCHES. NO PLAYGROUNDS, SWING SETS, TRAMPOLINES, SWIMMING POOLS, PICNIC TABLES, OR OTHER SIMILAR EQUIPMENT IS ALLOWED IN THE FRONT YARD OF ANY LOT. THE BOARD AND COMMITTEE MAY PROMULGATE RULES AND REGULATIONS REGARDING THE MAINTENANCE OF LOTS AND ADEQUATE ENFORCEMENT MECHANISMS IN THE EVENT A LOT IS NOT PROPERLY MAINTAINED. UPON FAILURE OF THE OWNER TO MAINTAIN OR LANDSCAPE THE GROUNDS OF ANY LOT IN ACCORDANCE WITH THE PROVISIONS ABOVE, THE ASSOCIATION MAY, UPON 15 DAYS' WRITTEN NOTICE TO THE OWNER, CAUSE THE GRASS, WEEDS AND VEGETATION TO BE CUT. THE COST OF ANY MAINTENANCE REQUIRED UNDER THIS SUBSECTION M. AND ANY ENFORCEMENT COSTS SHALL BE ASSESSED TO THE OWNER, AND SHALL CONSTITUTE A LIEN UPON THE LOT, AND MAY BE COLLECTED IN ACCORDANCE WITH SUBSECTION V.C.

N. RECREATIONAL VEHICLES AND ACCESSORIES:

NO BOATS, TRAILERS, RECREATIONAL VEHICLES, OR VEHICLES USED FOR RECREATIONAL PURPOSES ARE ALLOWED IN THE SUBDIVISION UNLESS THEY WILL FIT ENTIRELY INTO A PRIVATE GARAGE.

O. STORAGE AND CONSTRUCTION MATERIALS:

CONSTRUCTION MATERIALS MAY ONLY BE STORED ON A LOT FOR THIRTY (30) DAYS PRIOR TO THE COMMENCEMENT OF CONSTRUCTION. THEREAFTER, CONSTRUCTION IS TO BE COMPLETED WITHIN A REASONABLE PERIOD OF TIME. THE DECLARANT SHALL BE ALLOWED TO STORE MATERIALS ON A LOT IN AN ORDERLY FASHION AS LONG AS MAY BE REASONABLY NECESSARY.

P. GARBAGE/DUMPING:

DUMPING IS PROHIBITED IN THE SUBDIVISION. ALL TRASH, GARBAGE OR OTHER WASTE SHALL BE KEPT IN SANITARY CONTAINERS STORED BEHIND THE RESIDENCE OR WITHIN ENCLOSED GARAGES AND MUST BE KEPT OUT OF STREET VIEW EXCEPT TWELVE (12) HOURS PRIOR TO AND 12 HOURS AFTER THE NORMAL CURBSIDE PICKUP TIME. ALL LOTS SHALL BE MAINTAINED IN A NEAT AND ORDERLY CONDITION AT ALL TIMES.

Q. MODEL HOME AND CONSTRUCTION FACILITIES:

MODEL HOMES FOR THE PURPOSES OF HOME SALES ARE PERMITTED BY THE DECLARANT. THE GARAGE OF MODEL HOMES MAY BE USED AS SALES OFFICES. ONE TRAILER OR TEMPORARY BUILDING MAY BE LOCATED ON A RESIDENTIAL LOT BY THE DECLARANT AND USED AS A CONSTRUCTION OFFICE UNTIL THE SUBDIVISION REACHES ONE-HUNDRED PERCENT (100%) OCCUPANCY.

SECTION V. HOME OWNERS ASSOCIATION

A. FORMATION OF HOME OWNERS ASSOCIATION; ADDITIONAL LANDS:

THE OWNER HAS FORMED OR SHALL CAUSE TO BE FORMED A HOME OWNERS ASSOCIATION ("HOA"), TO GOVERN THIS SUBDIVISION. THE HOA SHALL BE ESTABLISHED IN ACCORDANCE WITH THE STATUTES OF THE STATE OF OKLAHOMA AND BYLAWS PREPARED BY OWNER OR ITS ASSIGNEE, FOR THE GENERAL PURPOSES OF MAINTAINING THE COMMON AREAS, INCLUDING WITHOUT LIMITATION ALL RESERVE AREAS, AND ENHANCING THE VALUE, DESIRABILITY, AND ATTRACTIVENESS OF THE SUBDIVISION AND ANY ADDITIONS THERETO.

OWNER SHALL BE ENTITLED TO APPOINT THE BOARD OF DIRECTORS FOR THE HOA AS PROVIDED IN THE BYLAWS. IT IS CONTEMPLATED THAT ADDITIONAL LANDS/PHASES ADJOINING THE SUBDIVISION, AND SUBSEQUENTLY PLATTED FOR SINGLE FAMILY RESIDENTIAL PURPOSES MAY BE ANNEXED BY THE OWNER (OR ITS ASSIGNEE OR AN AFFILIATED CORPORATE OWNER) TO THE SUBDIVISION AND GEOGRAPHIC JURISDICTION AND BYLAWS OF THE HOA, WHICH MAY BE ACCOMPLISHED BY THE OWNER (OR ITS ASSIGNEE OR AN AFFILIATED CORPORATE OWNER) BY FILING A SUPPLEMENTAL DECLARATION HERETO, OR BY NOTING SUCH ANNEXATION ON A SEPARATE DEED OF DEDICATION FOR THE ADDITIONAL LANDS/PHASES TO BE ANNEXED HERETO, OR OTHER INSTRUMENT ADDING SUCH ADDITIONAL LANDS/PHASES TO THE SUBDIVISION AND THE JURISDICTION OF THE HOA, IN WHICH CASE ANY SUCH LANDS/PHASES AND THE SUBSEQUENT OWNERS THEREOF SHALL BE UNDER THE JURISDICTION OF THE HOA AND ALL RULES PERTAINING THERETO.

B. MEMBERSHIP:

EVERY PERSON OR ENTITY WHO ACCEPTS A DEED FOR A LOT IN THE SUBDIVISION AND IS A RECORD OWNER OF THE FEE INTEREST OF A LOT IN THE SUBDIVISION SHALL BE A MEMBER OF THE HOA AND SUBJECT TO ITS BYLAWS AND RULES. MEMBERSHIP SHALL BE APPURTENANT TO AND SHALL NOT BE SEPARATED FROM THE OWNERSHIP OF A LOT.

C. ASSESSMENT:

EACH OWNER OF A LOT, EXCEPT OWNER/DECLARANT, BY ACCEPTANCE OF A DEED THEREFOR, IS DEEMED TO COVENANT AND AGREE TO PAY TO THE HOA CERTAIN ASSESSMENTS TO BE ESTABLISHED BY THE BOARD OF DIRECTORS IN ACCORDANCE WITH THESE COVENANTS, AND AS AMENDED, AND THE BYLAWS OF THE HOA, TO BE EXECUTED BY THE OWNER FOR THE MAINTENANCE AND IMPROVEMENT OF THE COMMON AREAS OWNED OR MAINTAINED BY THE HOA AND FOR OTHER PURPOSES WHICH BENEFIT THE SUBDIVISION AND THE OWNERS OF LOTS THEREIN, AND ANY SUCH ASSESSMENTS SHALL BE A LIEN ON THE LOT AGAINST WHICH IT IS MADE, BUT THE LIEN SHALL BE SUBORDINATE TO THE LIEN OF ANY FIRST MORTGAGE.

D. MAINTENANCE OF COMMON AREAS:

THE HOA SHALL BE RESPONSIBLE FOR THE MAINTENANCE OF ALL COMMON AREAS AS DEPICTED ON THE PLAT OR AS DESCRIBED IN THESE COVENANTS, AND AS AMENDED, WHICH MAY INCLUDE BUT NOT BE LIMITED TO ENTRYWAYS, DETENTION/RETENTION PONDS, PERIMETER FENCING, AND OTHER COMMON AREAS AND RESERVE AREAS AS DEPICTED ON THE PLAT OR THESE COVENANTS, AND AS AMENDED.

E. LIMITATION ON LIABILITY:

THE HOA SHALL BE ENTITLED TO ALL PROTECTIONS AFFORDED UNDER OKLAHOMA'S GENERAL CORPORATION ACT AND ANY OTHER LAWS PROVIDING PROTECTION TO OWNER'S ASSOCIATIONS. NEITHER ANY MEMBER NOR OWNER, NOR THE DIRECTORS AND OFFICERS OF THE HOA SHALL BE PERSONALLY LIABLE FOR DEBTS CONTRACTED FOR OR OTHERWISE INCURRED BY THE HOA OR FOR ANY TORTS COMMITTED BY OR ON BEHALF OF THE HOA OR OTHERWISE. NEITHER THE OWNER, THE HOA, ITS DIRECTORS, OFFICERS, AGENTS OR EMPLOYEES SHALL BE LIABLE FOR ANY INCIDENTAL OR CONSEQUENTIAL DAMAGES, FOR FAILURE TO INSPECT ANY PREMISES, IMPROVEMENTS OR PORTION THEREOF, OR FOR FAILURE TO REPAIR OR MAINTAIN THE SAME.

SECTION VI. ENFORCEMENT, DURATION, AMENDMENT, TERMINATION, AND SEVERABILITY

A. ENFORCEMENT:

THE COVENANTS AND RESTRICTIONS SET FORTH HEREIN SHALL INURE TO THE BENEFIT OF AND SHALL BE ENFORCEABLE BY THE CITY THE HOA, THE OWNER, AND ANY OWNER OF A LOT, AND IN ANY JUDICIAL ACTION BROUGHT TO ENFORCE THE COVENANTS ESTABLISHED HEREIN, A PARTY MAY SEEK ALL APPROPRIATE REMEDIES AT LAW, INCLUDING INJUNCTIVE RELIEF, TO ENFORCE THE COVENANTS SET FORTH HEREIN. FAILURE TO DO SO SHALL NOT BE DEEMED A WAIVER OF ANY TERMS HEREOF OR OF THE RIGHT TO SEEK ACTION AGAINST FUTURE NONCOMPLIANCE. REASONABLE REGULATIONS CONCERNING THE PROPERTY AND COMMON AREAS MAY BE MADE AND AMENDED FROM TIME TO TIME BY THE OWNER OR ASSOCIATION. NO NOXIOUS OR OFFENSIVE ACTIVITY SHALL BE CARRIED ON IN, UPON, OR AROUND ANY RESIDENCE OR LOT OR IN OR UPON ANY COMMON AREA, NOR SHALL ANYTHING BE DONE THEREON WHICH MAY BE OR BECOME AN ANNOYANCE OR A NUISANCE TO OTHER OWNERS OR IN ANY WAY INTERFERE WITH THE QUIET ENJOYMENT OF SUCH OWNERS.

B. DURATION:

THESE COVENANTS SHALL RUN WITH THE LAND AND SHALL BE BINDING UPON THE OWNER AND ALL SUBSEQUENT OWNERS AND PERSONS CLAIMING UNDER THEM WITHIN THE SUBDIVISION FOR A PERIOD OF TWENTY (20) YEARS FROM THE DATE THIS PLAT IS FILED OF RECORD, AFTER WHICH TIME SAID COVENANTS SHALL BE DEEMED AUTOMATICALLY EXTENDED FOR SUCCESSIVE PERIODS OF TEN (10) YEARS UNLESS OTHERWISE AMENDED OR TERMINATED AS PROVIDED HEREIN.

C. AMENDMENT OR TERMINATION:

THE COVENANTS CONTAINED WITHIN SECTION I. PUBLIC STREETS, EASEMENTS, AND UTILITIES, SECTION II. RESERVE AREAS, AND SECTION III. PLANNED UNIT DEVELOPMENT RESTRICTIONS MAY BE AMENDED OR TERMINATED AT ANY TIME BY A WRITTEN INSTRUMENT SIGNED AND ACKNOWLEDGED BY THE OWNER OR ITS ASSIGNEE AND APPROVED BY THE CITY. NOTWITHSTANDING THE FOREGOING, THE COVENANTS CONTAINED WITHIN SECTION III. SHALL BE DEEMED AMENDED (WITHOUT NECESSITY OF EXECUTION OF AN AMENDING DOCUMENT) UPON APPROVAL OF A MINOR AMENDMENT TO PUD-001360-2024 BY THE BROKEN ARROW PLANNING COMMISSION AND RECORDING OF A CERTIFIED COPY OF THE MINUTES OF THE BROKEN ARROW PLANNING COMMISSION WITH THE TULSA COUNTY CLERK, OR UPON APPROVAL OF A MAJOR AMENDMENT TO PUD-001360-2024 UPON FILING OF RECORD AN ORDINANCE OR OTHER VALID RECORD OF CITY OF BROKEN ARROW APPROVAL.

EXCEPT FOR SECTIONS I., II., AND III. AS STATED ABOVE, OWNER OR ITS ASSIGNEE MAY SUPPLEMENT OR AMEND ANY OF THESE COVENANTS STATED HEREIN AT ANY TIME IN WHOLE OR IN PART BY EXECUTING AND RECORDING AN INSTRUMENT WITH THE COUNTY CLERK. ALTERNATIVELY, THESE COVENANTS MAY BE AMENDED AT ANY TIME BY A WRITTEN INSTRUMENT SIGNED AND ACKNOWLEDGED BY THE OWNERS OF SIXTY (60%) OF THE LOTS (SUBJECT TO OWNER OR OWNER'S ASSIGNEE CONSENT). THE PROVISIONS OF ANY INSTRUMENT SUPPLEMENTING OR AMENDING THESE COVENANTS SHALL BE EFFECTIVE FROM AND AFTER THE DATE IT IS RECORDED IN THE RECORDS OF THE COUNTY CLERK.

D. SEVERABILITY:

INVALIDATION OF ANY RESTRICTION SET FORTH HEREIN, OR ANY PART THEREOF, BY AN ORDER, JUDGMENT, OR DECREE OF ANY COURT, OR OTHERWISE, SHALL NOT INVALIDATE OR AFFECT ANY OF THE OTHER RESTRICTIONS OR ANY PART THEREOF SET FORTH HEREIN, WHICH SHALL REMAIN IN FULL FORCE AND EFFECT.

IN WITNESS WHEREOF, THE OWNER HAS CAUSED THESE PRESENTS TO BE EXECUTED THIS _____ DAY OF _____, 2025.

TULSA L DEV., LLC
AN OKLAHOMA LIMITED LIABILITY COMPANY

BY: _____
_____, MANAGER

STATE OF ARKANSAS)
_____) SS
COUNTY OF WASHINGTON)

BEFORE ME, THE UNDERSIGNED, A NOTARY PUBLIC IN AND FOR SAID COUNTY AND STATE, ON THIS _____ DAY OF _____, 2025, PERSONALLY APPEARED _____, TO ME KNOWN TO BE THE IDENTICAL PERSON WHO SUBSCRIBED THE NAME OF TULSA L DEV., LLC TO THE FOREGOING INSTRUMENT, AS ITS MANAGER, AND ACKNOWLEDGED TO ME THAT EXECUTED THE SAME AS FREE AND VOLUNTARY ACT AND DEED AND AS THE FREE AND VOLUNTARY ACT AND DEED OF TULSA L DEV., LLC FOR THE USES AND PURPOSES THEREIN SET FORTH.

GIVEN UNDER MY HAND AND SEAL THE DAY AND YEAR LAST ABOVE WRITTEN.

MY COMMISSION EXPIRES _____

NOTARY PUBLIC

CERTIFICATE OF SURVEY

I, DAN E. TANNER, A LICENSED PROFESSIONAL LAND SURVEYOR IN THE STATE OF OKLAHOMA, DO HEREBY CERTIFY THAT I HAVE CAREFULLY AND ACCURATELY SURVEYED, SUBDIVIDED, AND PLATTED THE TRACT OF LAND DESCRIBED HEREINAbove, AND THAT THE ACCOMPANYING PLAT IS A TRUE REPRESENTATION OF A SURVEY MADE ON THE GROUND USING GENERALLY ACCEPTED PRACTICES, AND MEETS OR EXCEEDS THE OKLAHOMA MINIMUM STANDARDS FOR THE PRACTICE OF LAND SURVEYING.

WITNESS MY HAND AND SEAL THIS _____ DAY OF _____, 2024.

BY: _____
DAN E. TANNER
LICENSED PROFESSIONAL LAND SURVEYOR
OKLAHOMA NO. 1435

STATE OF OKLAHOMA)
_____) SS
COUNTY OF TULSA)

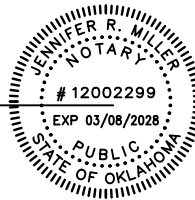
BEFORE ME, THE UNDERSIGNED, A NOTARY PUBLIC IN AND FOR SAID COUNTY AND STATE, ON THIS _____ DAY OF _____, 2024, PERSONALLY APPEARED TO ME DAN E. TANNER KNOWN TO BE THE IDENTICAL PERSON WHO SUBSCRIBED HIS NAME AS LICENSED PROFESSIONAL LAND SURVEYOR TO THE FOREGOING CERTIFICATE, AS HIS FREE AND VOLUNTARY ACT AND DEED, FOR THE USES AND PURPOSES THEREIN SET FORTH.

GIVEN UNDER MY HAND AND SEAL THE DAY AND YEAR LAST ABOVE WRITTEN.

03/08/2028

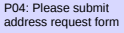
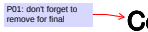
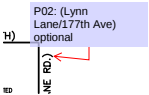
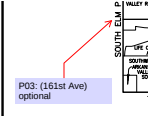
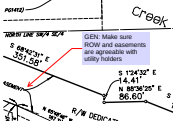
MY COMMISSION EXPIRES _____

NOTARY PUBLIC



23221_20250127_Spring Creek Crossing Conditional Final Plat_v1.pdf Markup Summary

Callout (9)

	Subject: Callout Author: JHensley	P04: Please submit address request form
	Subject: Callout Author: JHensley	P01: don't forget to remove for final
	Subject: Callout Author: JHensley	P07: Use the current zoning and PUD
	Subject: Callout Author: JHensley	P02: (Lynn Lane/177th Ave) optional
	Subject: Callout Author: JHensley	P03: (161st Ave) optional
	Subject: Callout Author: JHensley	P05: Per Previous review: Note wedge shaped lots are measured at the B/L
	Subject: Callout Author: JHensley	P06: Please remove
	Subject: Callout Author: JHensley	P08: I don't believe the City enforces covenants - review to make sure private and public don't overlap
	Subject: Callout Author: JHensley	GEN: Make sure ROW and easements are agreeable with utility holders

Rectangle (3)

ENCLOSING, AND FENCING:
ALL FENCING SHALL COMPLY WITH THE CITY OF

WITH PROPOSED RS-C ZONING, 50-FT
PRESERVED ALONG THE WEST AND E
RESIDENTIAL LOTS, WHICH AREAS SHA
5' ASSOCIATION. WITHIN THE REQUIR
ANY TREE WITH A MINIMUM OF 6 INCH
OF APPROVAL SHALL BE PRESERVED. OF

Subject: Rectangle
Author: JHensley

REQUIRED WITHIN THE
CT (TO BE RS-C)

Subject: Rectangle
Author: JHensley

ENFORCEMENT:

COVENANTS AND RESTRICTIONS SET
L BE ENFORCEABLE BY THE CITY. THE
JUDICIAL ACTION BROUGHT TO ENF
SEEK ALL APPROPRIATE REMEDIES /
COVENANTS SET FORTH HEREIN. FAIL
TERMS HEREOF OR OF THE RIGHT
ONABLE REGULATIONS CONCERNING

Subject: Rectangle
Author: JHensley