

OWNER/DEVELOPER

209TH STREET LLC
1420 W. KENOSHA ST.
BROKEN ARROW, OK 74012
PHONE: 918-258-6161
ATTN: GLENN SHAW


CONDITIONAL FINAL PLAT

The Cedars At The Preserve II

A SUBDIVISION OF THE PART OF THE WEST HALF OF THE NORTHWEST QUARTER (W/2 NW/4) AND PART OF THE NW/4 OF THE SW/4 OF SECTION 32, TOWNSHIP 19 NORTH, RANGE 15 EAST OF THE INDIAN BASE AND MERIDIAN, CITY OF BROKEN ARROW, WAGONER COUNTY, STATE OF OKLAHOMA. PUD-310

ENGINEER/SURVEYOR

AAB ENGINEERING LLC
CERTIFICATE OF AUTHORIZATION NO. 6318, EXP. JUNE, 30, 2026
PO BOX 2136
SAND SPRINGS, OK 74063
PHONE: 918.514.4283
FAX: 918.514.4288
EMAIL: ALAN@AABENG.COM

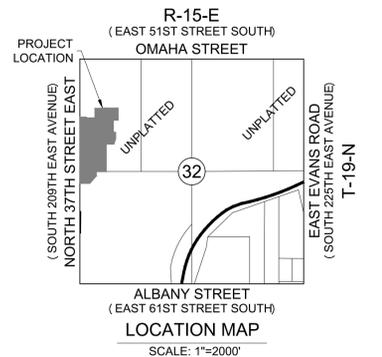

SUBDIVISION STATISTICS

SUBDIVISION CONTAINS ONE HUNDRED NINETEEN (119) LOTS IN SIX (6) BLOCKS AND TWO (2) RESERVE AREAS CONTAINING 27.71 ACRES

BLOCK 1	5.47 ACRES - 32 LOTS
BLOCK 2	2.47 ACRES - 14 LOTS
BLOCK 3	2.27 ACRES - 14 LOTS
BLOCK 4	3.37 ACRES - 22 LOTS
BLOCK 5	2.56 ACRES - 11 LOTS
BLOCK 6	4.31 ACRES - 26 LOTS
RESERVE A	0.02 ACRES
RESERVE B	0.33 ACRES

SITE DATA

BENCHMARK
TOP OF RAILROAD SPIKE AT NORTHWEST CORNER OF SEC. 32
T-19-N, R-15-E
ELEV. = 686.76' (NAVD '88)

BASIS OF BEARINGS
GRID BEARING BASED ON THE OKLAHOMA STATE PLAN COORDINATE SYSTEM - NORTH 3501 WITH A BEARING OF N 88°48'13" E BEING THE NORTH LINE OF THE NORTHWEST QUARTER OF SECTION 32 T-19N R-15-E.

LAND AREA
1,207,028 SF / 27.71 ACRES±


MONUMENTATION
A 3/8"X 18" REBAR WITH A YELLOW PLASTIC CAP STAMPED "6318" TO BE SET AT ALL LOT CORNERS, ALL STREET CENTERLINE INTERSECTIONS, POINTS OF CURVE, POINTS OF TANGENT, POINTS OF COMPOUND CURVE, POINTS OF REVERSE CURVE, CENTER OF CUL-DE-SACS AND CENTER OF EYEBROWS, AFTER COMPLETION OF IMPROVEMENTS, UNLESS NOTED OTHERWISE.

ADDRESSES
ADDRESSES SHOWN ON THIS PLAT WERE ACCURATE AT THE TIME THIS PLAT WAS FILED. ADDRESSES ARE SUBJECT TO CHANGE AND SHOULD NEVER BE RELIED ON IN PLACE OF LEGAL DESCRIPTION.

DETENTION DETERMINATION
DETENTION DETERMINATION NUMBER: DD-062824-35

LEGEND

- B/L.....BUILDING LINE
- L.N.A.....LIMITS OF NO ACCESS
- POB.....POINT OF BEGINNING
- POC.....POINT OF COMMENCEMENT
- ROW.....RIGHT OF WAY
- U/E.....UTILITY EASEMENT
- F/L/E.....FENCE AND LANDSCAPE EASEMENT
- S/E.....SIDEWALK EASEMENT
- BK.....BOOK
- PG.....PAGE
- R.A.....RESTRICTED ACCESS
- 1234.....ADDRESS
- IP/S.....IRON PIN SET
- PK/S.....PK NAIL SET
- OD/E.....OVERLAND DRAINAGE EASEMENT
-FENCE PROHIBITION EASEMENT

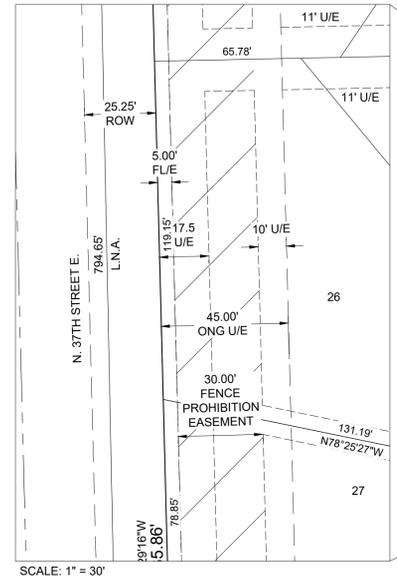

NW CORNER SEC. 32,
T-19-N R-15-E
FOUND RR SPIKE
BENCHMARK
POINT OF COMMENCEMENT



CONTACTS

MUNICIPAL AUTHORITY
CITY OF BROKEN ARROW
210 SOUTH 1ST STREET
BROKEN ARROW, OK 74012

UTILITY CONTACTS

OKLAHOMA NATURAL GAS COMPANY	AEP / P/SO
5848 EAST 15TH STREET BROKEN ARROW, OK 74112 PHONE: 918.831.8293	212 EAST 6TH STREET BROKEN ARROW, OK 74119 PHONE: 918.599.2351
WINDSTREAM TELECOM COMPANY	COX COMMUNICATIONS
2300 EAST 1ST PLACE BROKEN ARROW, OK 74012 PHONE: 918.451.3427	11811 EAST 51ST STREET BROKEN ARROW, OK 74145 PHONE: 918.286.4658
WAGONER COUNTY RURAL WATER DISTRICT #4	
9816 S. 239TH EAST AVENUE BROKEN ARROW, OKLAHOMA 74014 918-258-2331	

APPROVED BY THE CITY COUNCIL OF THE CITY OF BROKEN ARROW, OKLAHOMA ON

MAYOR _____
ATTEST: CITY CLERK _____

BENCHMARK
TOP OF RAILROAD SPIKE AT NORTHWEST CORNER OF SEC. 32 T-19-N, R-15-E
ELEV. = 686.76' (NAVD '88)

CONTINUES ON PAGE 2



OWNER/DEVELOPER
 209TH STREET LLC
 1420 W. KENOSHIA ST.
 BROKEN ARROW, OK 74012
 PHONE: 918-258-6161
 ATTN: GLENN SHAW


CONDITIONAL FINAL PLAT

The Cedars At The Preserve II


A SUBDIVISION OF THE PART OF THE WEST HALF OF THE NORTHWEST QUARTER (W/2 NW/4) AND PART OF THE NW/4 OF THE SW/4 OF SECTION 32, TOWNSHIP 19 NORTH, RANGE 15 EAST OF THE INDIAN BASE AND MERIDIAN, CITY OF BROKEN ARROW, WAGONER COUNTY, STATE OF OKLAHOMA. PUD-310

ENGINEER/SURVEYOR

AAB ENGINEERING LLC
 CERTIFICATE OF AUTHORIZATION NO. 6318, EXP. JUNE, 30, 2026
 PO BOX 2136
 SAND SPRINGS, OK 74063
 PHONE: 918.514.4283
 FAX: 918.514.4288
 EMAIL: ALAN @ AABENG.COM

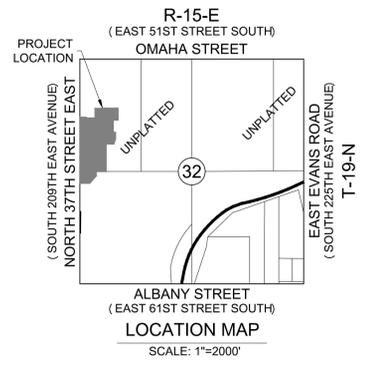

CONTINUES ON PAGE 1

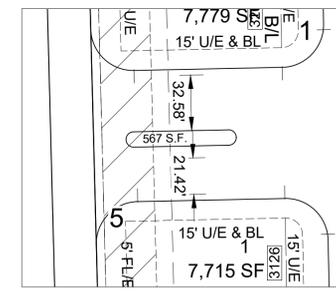

Reserve Area A
 Scale: 1" = 50'

CONTACTS

MUNICIPAL AUTHORITY
 CITY OF BROKEN ARROW
 210 SOUTH 1ST STREET
 BROKEN ARROW, OK 74012

UTILITY CONTACTS

OKLAHOMA NATURAL GAS COMPANY AEP / PSO
 5849 EAST 15TH STREET BROKEN ARROW, OK 74119
 PHONE: 918.831.8293

WINDSTREAM TELECOM COMPANY
 2300 EAST 1ST PLACE BROKEN ARROW, OK 74145
 PHONE: 918.451.3427

WAGONER COUNTY RURAL WATER DISTRICT #4
 9816 S. 239TH EAST AVENUE BROKEN ARROW, OKLAHOMA 74014
 918-258-2331

FLOODPLAIN


PORTIONS OF THIS PROPERTY ARE LOCATED WITHIN ZONE "AE" PER FIRM PANEL "40145C0105J" DATED SEPTEMBER 30, 2016.

ZONING PUD-310

FRONT YARD SETBACK.....25 FEET
 REAR YARD SETBACK.....20 FEET
 INTERIOR SIDE YARD SETBACK.....5 FEET

LEGEND

B/L.....BUILDING LINE
 L.N.A.....LIMITS OF NO ACCESS
 POB.....POINT OF BEGINNING
 POC.....POINT OF COMMENCEMENT
 ROW.....RIGHT OF WAY
 U/E.....UTILITY EASEMENT
 FLE.....FENCE AND LANDSCAPE EASEMENT
 S/E.....SIDEWALK EASEMENT
 BK.....BOOK
 PG.....PAGE
 R.A.....RESTRICTED ACCESS
 [1234].....ADDRESS
 IPS.....IRON PIN SET
 PKS.....PK NAIL SET
 ODE.....OVERLAND DRAINAGE EASEMENT
 [Hatched].....FENCE PROHIBITION EASEMENT

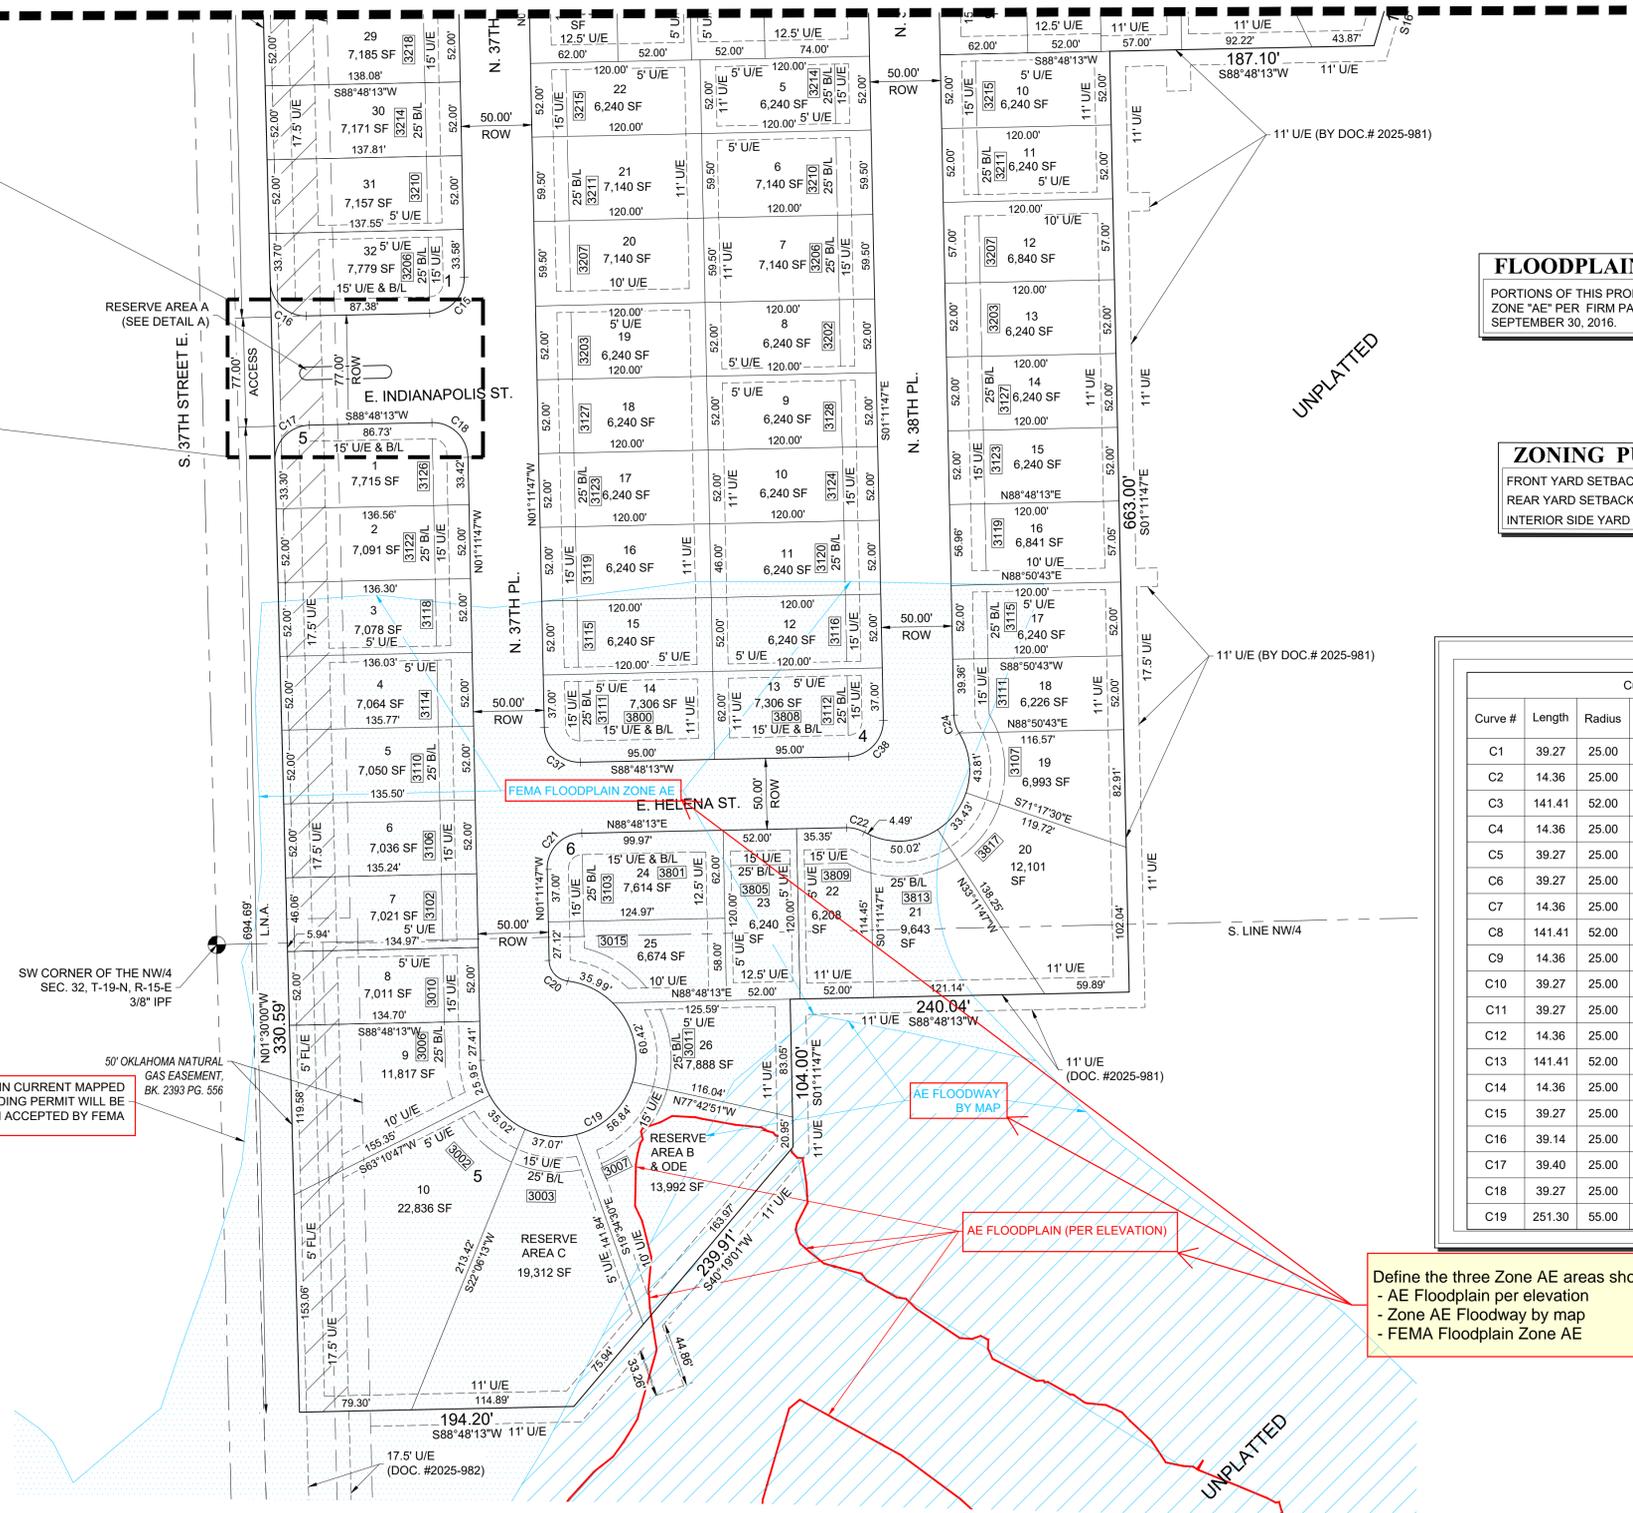

Show the minimum Pad Elevations on the properties within the floodplain.

ALL PROPERTIES ARE WITHIN CURRENT MAPPED FLOODPLAIN. NO BUILDING PERMIT WILL BE ISSUED UNTIL THE LOMR HAS BEEN ACCEPTED BY FEMA

Define the three Zone AE areas shown on the plat.
 - AE Floodplain per elevation
 - Zone AE Floodway by map
 - FEMA Floodplain Zone AE

Curve Table						Curve Table					
Curve #	Length	Radius	Delta	CHORD LENGTH	CHORD BEARING	Curve #	Length	Radius	Delta	CHORD LENGTH	CHORD BEARING
C1	39.27	25.00	090.0000	35.36	S43°48'13"W	C20	21.41	15.00	081.7868	19.64	S42°05'23"E
C2	14.36	25.00	032.9083	14.16	N74°44'32"W	C21	39.27	25.00	090.0000	35.36	S43°48'13"W
C3	141.41	52.00	155.8166	101.69	S43°48'13"W	C22	13.29	25.00	030.4662	13.14	N75°57'48"W
C4	14.36	25.00	032.9083	14.16	S17°39'02"E	C23	131.71	50.00	150.9323	96.80	S43°48'13"W
C5	39.27	25.00	089.9999	35.36	S43°48'13"W	C24	13.29	25.00	030.4662	13.14	S16°25'46"E
C6	39.27	25.00	090.0000	35.36	N46°11'47"W	C25	39.27	25.00	090.0000	35.36	S43°48'13"W
C7	14.36	25.00	032.9083	14.16	N15°15'28"E	C26	13.29	25.00	030.4662	13.14	N75°57'48"W
C8	141.41	52.00	155.8166	101.69	N46°11'47"W	C27	131.71	50.00	150.9323	96.80	S43°48'13"W
C9	14.36	25.00	032.9083	14.16	S72°20'58"W	C28	13.29	25.00	030.4662	13.14	S16°25'46"E
C10	39.27	25.00	090.0000	35.36	N46°11'47"W	C29	39.27	25.00	090.0000	35.36	S43°48'13"W
C11	39.27	25.00	090.0000	35.36	N43°48'13"E	C30	39.27	25.00	090.0000	35.36	S46°11'47"E
C12	14.36	25.00	032.9083	14.16	S74°44'32"E	C31	39.27	25.00	090.0000	35.36	S43°48'13"W
C13	141.41	52.00	155.8166	101.69	N43°48'13"E	C32	14.36	25.00	032.9083	14.16	N74°44'32"W
C14	14.36	25.00	032.9083	14.16	N17°39'02"W	C33	141.41	52.00	155.8166	101.69	S43°48'13"W
C15	39.27	25.00	090.0000	35.36	N43°48'13"E	C34	14.36	25.00	032.9083	14.16	S17°39'02"E
C16	39.14	25.00	089.7072	35.26	S46°20'34"E	C35	39.27	25.00	090.0000	35.36	N46°11'47"W
C17	39.40	25.00	090.2928	35.45	S43°39'26"W	C36	39.27	25.00	090.0000	35.36	S43°48'13"W
C18	39.27	25.00	090.0000	35.36	N46°11'47"W	C37	39.27	25.00	090.0000	35.36	S46°11'47"E
C19	251.30	55.00	261.7868	83.15	S47°54'37"W	C38	39.27	25.00	090.0000	35.36	N43°48'13"E

BENCHMARK

TOP OF RAILROAD SPIKE AT NORTHWEST CORNER OF SEC. 32 T-19-N, R-15-E
 ELEV. = 686.76' (NAVD '88)

APPROVED BY THE CITY COUNCIL OF THE CITY OF BROKEN ARROW, OKLAHOMA ON _____

MAYOR _____

ATTEST: CITY CLERK _____

The Cedars At The Preserve II

OWNER/DEVELOPER

209TH STREET LLC
1420 W. KENOSHA ST.
BROKEN ARROW, OK 74012
PHONE: 918-258-8161
ATTN: GLENN SHAW

A SUBDIVISION OF THE PART OF THE WEST HALF OF THE NORTHWEST QUARTER (W/2 NW/4) AND PART OF THE NW/4 OF THE SW/4 OF SECTION 32, TOWNSHIP 19 NORTH, RANGE 15 EAST OF THE INDIAN BASE AND MERIDIAN, CITY OF BROKEN ARROW, WAGONER COUNTY, STATE OF OKLAHOMA.
PUD-310

ENGINEER/SURVEYOR

AAB ENGINEERING LLC
CERTIFICATE OF AUTHORIZATION NO. 6318, EXP. JUNE. 30, 2026
PO BOX 2136
SAND SPRINGS, OK 74063
PHONE: 918.514.4283
FAX: 918.514.4288
EMAIL: ALAN@AABENG.COM

KNOW ALL MEN BY THESE PRESENTS:

209TH STREET, LLC, AN OKLAHOMA LIMITED LIABILITY COMPANY, HERINAFTER REFERRED TO AS THE "OWNER/DEVELOPER", IS THE OWNER OF THE FOLLOWING DESCRIBED LAND IN THE CITY OF BROKEN ARROW, WAGONER COUNTY, STATE OF OKLAHOMA, TO-WIT:

A TRACT OF LAND SITUATED IN THE WEST HALF (W/2) OF THE NORTHWEST QUARTER (NW/4) OF SECTION THIRTY-TWO (32), TOWNSHIP NINETEEN (19) NORTH, RANGE FIFTEEN (15) EAST OF THE INDIAN BASE AND MERIDIAN, ACCORDING TO THE U.S. GOVERNMENT SURVEY THEREOF, WAGONER COUNTY, STATE OF OKLAHOMA AND BEING MORE FULLY DESCRIBED AS FOLLOWS:

COMMENCING AT THE NORTHWEST CORNER OF SAID SECTION THIRTY-TWO (32), TOWNSHIP NINETEEN (19) NORTH, RANGE FIFTEEN (15) EAST, THENCE SOUTH 01°29'16" EAST ALONG THE WEST LINE OF SAID NORTHWEST QUARTER (NW/4), A DISTANCE OF 1407.50 FEET TO THE SOUTHWEST CORNER OF THE CEDARS AT THE PRESERVE I, A SUBDIVISION IN THE CITY OF BROKEN ARROW, PLAT DOC. #2023-11021 AND THE POINT OF BEGINNING; THENCE ALONG THE SOUTHERLY LINE OF SAID SUBDIVISION FOR THE NEXT NINE CALLS; THENCE NORTH 88°30'40" EAST, A DISTANCE OF 50.00 FEET TO THE EAST RIGHT OF WAY LINE OF N. 37TH ST. E.; THENCE ALONG A CURVE TO THE RIGHT, HAVING A RADIUS OF 35.00 FEET, A CHORD BEARING OF NORTH 43°39'28" EAST AND A CHORD DISTANCE OF 49.62 FEET, FOR AN ARC DISTANCE OF 55.16 FEET; THENCE NORTH 88°48'13" EAST, A DISTANCE OF 81.29 FEET; THENCE ALONG A CURVE TO THE RIGHT, HAVING A RADIUS OF 25.00 FEET, A CHORD BEARING OF SOUTH 46°11'47" EAST, A CHORD DISTANCE OF 35.36 FEET, FOR AN ARC DISTANCE OF 39.27 FEET; THENCE NORTH 88°48'13" EAST, A DISTANCE OF 50.00 FEET; THENCE NORTH 01°11'47" WEST, A DISTANCE OF 10.05 FEET; THENCE NORTH 88°48'13" EAST, A DISTANCE OF 129.79 FEET; THENCE NORTH 01°11'47" WEST, A DISTANCE OF 230.00 FEET; THENCE NORTH 88°48'13" EAST, A DISTANCE OF 569.60 FEET; THENCE SOUTH 01°11'47" EAST, A DISTANCE OF 294.98 FEET; THENCE NORTH 86°55'47" WEST, A DISTANCE OF 68.96 FEET; THENCE SOUTH 88°48'13" WEST, A DISTANCE OF 51.04 FEET; THENCE SOUTH 01°11'47" EAST, A DISTANCE OF 290.00 FEET; THENCE NORTH 88°48'13" EAST, A DISTANCE OF 58.00 FEET; THENCE SOUTH 01°11'47" EAST, A DISTANCE OF 158.05 FEET; THENCE SOUTH 16°39'06" WEST, A DISTANCE OF 138.82 FEET; THENCE SOUTH 88°48'13" WEST, A DISTANCE OF 187.10 FEET; THENCE SOUTH 01°11'47" EAST, A DISTANCE OF 663.00 FEET; THENCE SOUTH 88°48'13" WEST, A DISTANCE OF 240.04 FEET; THENCE SOUTH 01°11'47" EAST, A DISTANCE OF 104.00 FEET; THENCE SOUTH 40°19'01" WEST, A DISTANCE OF 239.91 FEET; THENCE SOUTH 88°48'13" WEST, A DISTANCE OF 194.20 FEET TO THE EAST RIGHT-OF-WAY LINE OF SOUTH 37TH STREET EAST. THENCE NORTH 01°30'00" WEST ALONG SAID EAST RIGHT-OF-WAY LINE, A DISTANCE OF 330.59 FEET; THENCE NORTH 01°29'16" WEST CONTINUING ALONG SAID EAST RIGHT-OF-WAY LINE, A DISTANCE OF 1235.86 FEET TO THE POINT OF BEGINNING. CONTAINING 1,128,701 SQUARE FEET OR 25.91 ACRES.

AND HAS CAUSED THE ABOVE DESCRIBED TRACT OF LAND TO BE SURVEYED, STAKED, PLATTED AND SUBDIVIDED INTO 119 LOTS IN 6 BLOCKS AND 2 RESERVE AREAS EACH ONE REFERRED TO HEREIN AS A "LOT" OR COLLECTIVELY AS "LOTS" IN CONFORMITY WITH THE ACCOMPANYING PLAT, AND HAS DESIGNATED THE SUBDIVISION AS "THE CEDARS AT THE PRESERVE II," A SUBDIVISION IN THE CITY OF BROKEN ARROW, WAGONER COUNTY, OKLAHOMA (HEREINAFTER REFERRED TO AS "THE CEDARS AT THE PRESERVE" OR THE "SUBDIVISION").

SECTION I. PUBLIC STREETS, EASEMENTS AND UTILITIES

A. PUBLIC STREETS AND GENERAL UTILITY EASEMENTS

THE OWNER/DEVELOPER DOES HEREBY DEDICATE FOR PUBLIC USE THE STREETS DEPICTED ON THE ACCOMPANYING PLAT AND DOES FURTHER DEDICATE FOR PUBLIC USE THE UTILITY EASEMENTS AS DEPICTED ON THE ACCOMPANYING PLAT AS "UTL" OR "UTILITY EASEMENT". FOR OWNER/DEVELOPER AND ALL UTILITY SERVICES WITH FRANCHISE RIGHTS WITHIN THE CITY OF BROKEN ARROW FOR THE SEVERAL PURPOSES OF CONSTRUCTING, MAINTAINING, OPERATING, REPAIRING, REPLACING, AND/OR REMOVING ANY AND ALL PUBLIC UTILITIES, INCLUDING STORM SEWERS, SANITARY SEWERS, TELEPHONE AND COMMUNICATION LINES, ELECTRIC POWER LINES AND TRANSFORMERS, GAS LINES, WATER LINES AND CABLE TELEVISION LINES, TOGETHER WITH ALL FITTINGS, INCLUDING THE POLES, WIRES, CONDUITS, PIPES, VALVES, METERS AND EQUIPMENT FOR EACH OF SUCH FACILITIES AND ANY OTHER APPURTENANCES THERETO, WITH THE RIGHTS OF INGRESS AND EGRESS TO AND UPON THE UTILITY EASEMENTS FOR THE USES AND PURPOSES AFORESAID, PROVIDED HOWEVER, THE OWNER/DEVELOPER HEREBY RESERVES THE RIGHT TO CONSTRUCT, MAINTAIN, OPERATE, LAY AND RE-LAY ALL UTILITY LINES, INCLUDING WATER LINES AND SEWER LINES, EXCLUDING GAS LINES AND GAS SERVICE LINES, TOGETHER WITH THE RIGHT OF INGRESS AND EGRESS FOR SUCH CONSTRUCTION, MAINTENANCE, OPERATION, LAYING AND RE-LAYING OVER, ACROSS AND ALONG ALL OF THE UTILITY EASEMENTS DEPICTED ON THE PLAT, FOR THE PURPOSE OF FURNISHING WATER SERVICE, SEWER SERVICE AND ALL UTILITY SERVICES, EXCLUDING NATURAL GAS, TO THE AREA INCLUDED IN THE PLAT AND ELSEWHERE, AS MAY BE REQUIRED. THE OWNER/DEVELOPER HEREIN IMPOSES A RESTRICTIVE COVENANT, WHICH COVENANT SHALL BE BINDING ON EACH LOT OWNER AND SHALL BE ENFORCEABLE BY THE CITY OF BROKEN ARROW, OKLAHOMA, AND BY THE SUPPLIER OF ANY AFFECTED UTILITY SERVICE, THAT WITHIN THE UTILITY EASEMENTS DEPICTED ON THE ACCOMPANYING PLAT NO BUILDING, STRUCTURE OR OTHER ABOVE OR BELOW GROUND OBSTRUCTION SHALL BE PLACED, ERECTED, INSTALLED OR MAINTAINED, PROVIDED HOWEVER, NOTHING HEREIN SHALL BE DEEMED TO PROHIBIT DRIVES, PARKING AREAS, CURBING, LANDSCAPING, CUSTOMARY SCREENING FENCES AND WALLS THAT DO NOT CONSTITUTE AN OBSTRUCTION.

B. UTILITY LINES AND SERVICE

- OVERHEAD LINES FOR THE SUPPLY OF ELECTRIC, TELEPHONE AND CABLE TELEVISION SERVICES AND OTHER COMMUNICATION SERVICES MAY BE LOCATED ALONG THE PERIMETER EASEMENTS OF THE SUBDIVISION. STREET LIGHT POLES OR STANDARDS MAY BE SERVED BY OVERHEAD LINE OR UNDERGROUND CABLE THROUGHOUT THE SUBDIVISION. OTHERWISE, ALL SUPPLY LINES SHALL BE LOCATED UNDERGROUND IN THE GENERAL UTILITY EASEMENTS AND IN THE RIGHTS-OF-WAY FOR PUBLIC STREETS AS DEPICTED BY THE PLAT. SERVICE PEDESTALS AND TRANSFORMERS, AS SOURCES OF SUPPLY AT SECONDARY VOLTAGES, MAY ALSO BE LOCATED IN THE GENERAL UTILITY EASEMENTS.
- UNDERGROUND SERVICE CABLES TO ALL STRUCTURES WHICH MAY BE LOCATED WITHIN THE SUBDIVISION MAY BE RUN FROM THE NEAREST SERVICE PEDESTAL OR TRANSFORMER TO THE POINT OF USAGE DETERMINED BY THE LOCATION AND CONSTRUCTION OF SUCH STRUCTURE AS MAY BE LOCATED UPON THE LOT, PROVIDED THAT UPON THE INSTALLATION OF A SERVICE CABLE TO A PARTICULAR STRUCTURE, THE SUPPLIER OF SERVICE SHALL THEREAFTER BE DEEMED TO HAVE A DEFINITE, PERMANENT AND EFFECTIVE EASEMENT ON THE LOT, COVERING A 5 FOOT STRIP EXTENDING 2.5 FEET ON EACH SIDE OF THE SERVICE CABLE, EXTENDING FROM THE SERVICE PEDESTAL OR TRANSFORMER TO THE SERVICE ENTRANCE ON THE STRUCTURE.
- THE SUPPLIER OF ELECTRIC, TELEPHONE AND CABLE TELEVISION SERVICES AND OTHER COMMUNICATION SERVICES, THROUGH ITS AGENTS AND EMPLOYEES, SHALL AT ALL TIMES HAVE RIGHT OF ACCESS TO ALL GENERAL UTILITY EASEMENTS DEPICTED ON THE ACCOMPANYING PLAT OR OTHERWISE PROVIDED FOR IN THIS DEED OF DEDICATION FOR THE PURPOSE OF INSTALLING, MAINTAINING, REMOVING OR REPLACING ANY PORTION OF THE UNDERGROUND ELECTRIC, TELEPHONE, CABLE TELEVISION OR COMMUNICATION FACILITIES INSTALLED BY THE SUPPLIER OF THE UTILITY SERVICE.
- THE OWNER OF THE LOT SHALL BE RESPONSIBLE FOR THE PROTECTION OF THE UNDERGROUND SERVICE FACILITIES LOCATED ON HIS LOT AND SHALL PREVENT THE ALTERATION OF GRADE OR ANY CONSTRUCTION ACTIVITY THAT WOULD INTERFERE WITH THE ELECTRIC, TELEPHONE, CABLE TELEVISION OR COMMUNICATION FACILITIES. THE SUPPLIER OF SERVICE SHALL BE RESPONSIBLE FOR ORDINARY MAINTENANCE OF UNDERGROUND FACILITIES, BUT THE OWNER SHALL PAY FOR DAMAGE OR RELOCATION OF SUCH FACILITIES CAUSED OR NECESSITATED BY ACTS OF THE OWNER OR HIS AGENTS OR CONTRACTORS.
- THE FOREGOING COVENANTS SET FORTH IN THIS PARAGRAPH B SHALL BE ENFORCEABLE BY THE SUPPLIER OF THE ELECTRIC, TELEPHONE, CABLE TELEVISION OR OTHER COMMUNICATION SERVICE AND THE OWNER OF THE LOT AGREES TO BE BOUND HEREBY.

C. WATER, SANITARY SEWER AND STORM SEWER SERVICE

- THE OWNER OF THE LOT SHALL BE RESPONSIBLE FOR THE PROTECTION OF THE PUBLIC WATER MAINS, SANITARY SEWER MAINS AND STORM SEWERS LOCATED ON THEIR LOT AND SHALL PREVENT THE ALTERATION OF GRADE OR ANY CONSTRUCTION ACTIVITY WHICH MAY INTERFERE WITH SAID PUBLIC WATER MAIN, PUBLIC SANITARY SEWER MAIN OR STORM SEWER.
- WITHIN THE UTILITY AND DRAINAGE EASEMENT AREAS DEPICTED ON THE ACCOMPANYING PLAT, THE ALTERATION OF GRADE FROM THE CONTOURS EXISTING UPON THE COMPLETION OF THE INSTALLATION OF A PUBLIC WATER MAIN, SANITARY SEWER MAIN, STORM SEWER OR DRAINAGEWAYS, OR ANY CONSTRUCTION ACTIVITY WHICH WOULD INTERFERE WITH PUBLIC WATER MAINS, SANITARY SEWER MAINS AND STORM SEWERS SHALL BE PROHIBITED. THE CITY OF BROKEN ARROW, INTER ALIA, MAY SPECIFICALLY ENFORCE THIS PROVISION.
- WAGONER COUNTY RURAL WATER DISTRICT #4, OR ITS SUCCESSORS AS THE PROVIDER, SHALL BE RESPONSIBLE FOR ORDINARY MAINTENANCE OF PUBLIC WATER MAINS, BUT THE OWNER SHALL PAY FOR DAMAGE OR RELOCATION OF SUCH FACILITIES CAUSED OR NECESSITATED BY ACTS OF THE OWNER, HIS AGENTS OR CONTRACTORS.
- THE CITY OF BROKEN ARROW, OKLAHOMA, OR ITS SUCCESSORS, SHALL AT ALL TIMES HAVE RIGHT OF ACCESS TO ALL EASEMENTS DEPICTED ON THE ACCOMPANYING PLAT, OR OTHERWISE PROVIDED FOR IN THIS DEED OF DEDICATION, FOR THE PURPOSE OF INSTALLING, MAINTAINING, REMOVING OR REPLACING ANY PORTION OF UNDERGROUND WATER OR SEWER FACILITIES OR STORM WATER FACILITIES. WAGONER COUNTY RURAL WATER DISTRICT #4 SHALL HAVE SUCH RIGHT OF ACCESS FOR THE PURPOSE OF INSTALLING, MAINTAINING, REMOVING OR REPLACING ANY PORTION OF POTABLE WATER FACILITIES. ITS SUCCESSOR UTILITY OR MUNICIPALITY PROVIDING WATER SERVICE SHALL HAVE SIMILAR RIGHT OF ACCESS.
- WHERE WATER LINES ARE INSTALLED WITHIN A UTILITY EASEMENT, THAT PORTION OF THE UTILITY EASEMENT IS FOR THE USE OF WAGONER COUNTY RURAL WATER DISTRICT #4, OKLAHOMA, OR ITS SUCCESSORS. THE UTILITY EASEMENTS DEDICATED HEREIN FOR THE PURPOSE OF PROVIDING POTABLE WATER ARE DEDICATED TO WAGONER COUNTY RURAL WATER DISTRICT #4, OR ITS SUCCESSORS OR ASSIGNS, AS THE EXCLUSIVE PROVIDER OF POTABLE WATER TO THE SUBDIVISION. SEWER, GAS, ELECTRIC, COMMUNICATION, CABLE, SOLID WASTE MANAGEMENT, AND OTHER PROVIDERS OF UTILITIES, OTHER THAN POTABLE WATER, MAY ALSO USE SAID EASEMENTS.
- THE FOREGOING COVENANTS SET FORTH IN THIS PARAGRAPH C SHALL BE ENFORCEABLE BY THE CITY OF BROKEN ARROW, OKLAHOMA, WAGONER COUNTY RURAL WATER DISTRICT #4, THEIR SUCCESSORS, OR ANY UTILITY PROVIDER OF SERVICES AND THE OWNER OF THE LOT AGREES TO BE BOUND HEREBY.

D. PAVING AND LANDSCAPING WITHIN EASEMENTS

THE OWNER OF THE LOT AFFECTED SHALL BE RESPONSIBLE FOR THE REPAIR OF DAMAGE TO LANDSCAPING AND PAVING OCCASIONED BY NECESSARY INSTALLATION OR MAINTENANCE OF UNDERGROUND WATER, SEWER, STORM SEWER, NATURAL GAS, COMMUNICATION, CABLE TELEVISION OR ELECTRIC FACILITIES WITHIN THE EASEMENT AREAS DEPICTED UPON THE ACCOMPANYING PLAT, PROVIDED, HOWEVER, THE CITY OF BROKEN ARROW, OKLAHOMA, OR THE SUPPLIER OF THE UTILITY SERVICE SHALL USE REASONABLE CARE IN THE PERFORMANCE OF SUCH ACTIVITIES.

E. GAS SERVICE

- THE OWNER OF THE LOT SHALL BE RESPONSIBLE FOR THE PROTECTION OF THE UNDERGROUND GAS FACILITIES LOCATED ON THE LOT.
- WITHIN THE DEPICTED UTILITY EASEMENT AREAS, THE ALTERATION OF GRADE OR ANY CONSTRUCTION ACTIVITY WHICH MAY INTERFERE WITH THE UNDERGROUND GAS FACILITIES, SHALL BE PROHIBITED.
- THE SUPPLIER OF GAS SERVICE OR ITS SUCCESSORS SHALL BE RESPONSIBLE FOR ORDINARY MAINTENANCE OF THE GAS FACILITIES, BUT THE OWNER SHALL PAY FOR DAMAGE OR RELOCATION OF SUCH FACILITIES CAUSED OR NECESSITATED BY ACTS OF THE OWNER, HIS AGENTS OR CONTRACTORS.
- THE SUPPLIER OF GAS SERVICE OR ITS SUCCESSORS SHALL AT ALL TIMES HAVE RIGHT OF ACCESS WITH THEIR EQUIPMENT TO ALL EASEMENT WAYS DEPICTED ON THE PLAT OR OTHERWISE PROVIDED FOR IN THIS DEED OF DEDICATION FOR THE PURPOSE OF INSTALLING, MAINTAINING, REMOVING OR REPLACING ANY PORTION OF UNDERGROUND GAS FACILITIES.
- UNDERGROUND GAS SERVICE LINES TO ALL STRUCTURES WHICH MAY BE LOCATED WITHIN THE SUBDIVISION MAY BE RUN FROM THE NEAREST GAS MAIN TO THE POINT OF USAGE DETERMINED BY THE LOCATION AND CONSTRUCTION OF SUCH STRUCTURE AS MAY BE LOCATED UPON THE LOT, PROVIDED THAT UPON THE INSTALLATION OF A SERVICE LINE TO A PARTICULAR STRUCTURE, THE SUPPLIER OF SERVICE SHALL THEREAFTER BE DEEMED TO HAVE A DEFINITIVE, PERMANENT AND EFFECTIVE EASEMENT ON THE LOT, COVERING A 5 FOOT STRIP EXTENDING 2.5 FEET ON EACH SIDE OF THE SERVICE LINE, EXTENDING FROM THE GAS MAIN TO THE SERVICE ENTRANCE ON THE STRUCTURE.
- ONG'S EASEMENT(S) RECORDED IN BOOK 835, PAGE 429, AND BOOK 835, PAGE 787, AND BOOK 2453, PAGE 776, REMAIN IN FULL FORCE AND EFFECT. ONG'S EASEMENT(S) PRE-DATE THE RIGHT-OF-WAY DEDICATION IN THIS PLAT AND MAY PROHIBIT OR LIMIT CERTAIN USES OF ONG'S RIGHT OF WAY, INCLUDING PAVING, OTHER UTILITY LINES, AND PERMANENT STRUCTURES, WITHOUT ONG'S PRIOR WRITTEN CONSENT.
- THE FOREGOING COVENANTS SET FORTH IN THIS SUBSECTION E SHALL BE ENFORCEABLE BY THE SUPPLIER OF GAS SERVICE OR ITS SUCCESSORS AND THE OWNER OF THE LOT AGREES TO BE BOUND HEREBY.

F. RESERVE AREA A

THE USE OF RESERVE AREA A SHALL BE LIMITED TO OPEN SPACE, RECREATION, LANDSCAPING AND UTILITIES. THE RESERVE AREA SHALL SUBSEQUENTLY BE CONVEYED TO THE HOMEOWNERS' ASSOCIATION TO BE FORMED PURSUANT TO SECTION IV FOR THE PURPOSES OF THE ADMINISTRATION AND MAINTENANCE OF RESERVES AND OTHER COMMON AREAS OF THE SUBDIVISION. RESERVE AREA A IS LOCATED WITHIN AND IS A PART OF THE PUBLIC RIGHT-OF-WAY. THE OWNER/DEVELOPER OF THE CEDARS AT THE PRESERVE II IS PERMITTED TO INSTALL LANDSCAPING, LIGHTING, SIGNAGE, AND IRRIGATION SYSTEMS IN THIS AREA. IT IS ALSO EXPRESSLY UNDERSTOOD THAT THE MAINTENANCE OF THIS RESERVE AREA IS THE RESPONSIBILITY OF THE OWNER. THE CITY OF BROKEN ARROW SHALL HAVE NO LIABILITY FOR ANY DAMAGE TO, INCLUDING BUT NOT LIMITED TO SIGNAGE, LIGHTING, LANDSCAPING, OR IRRIGATION SYSTEMS WITHIN RESERVE AREA A. THE CITY OF BROKEN ARROW ALSO RESERVES THE RIGHT TO MODIFY, RECONSTRUCT, OR REMOVE THE MEDIANS IN RESERVE AREA A.

G. RESERVE AREA B

THE USE OF RESERVE AREA B DEDICATED ON THE PLAT FOR THE SUBDIVISION SHALL BE LIMITED TO USE AS OPEN SPACE, FENCING, LANDSCAPING AND FLOODPLAIN AS WELL AS UTILITY EASEMENTS AND IS RESERVED FOR SUBSEQUENT CONVEYANCE TO THE HOMEOWNERS ASSOCIATION. MAINTENANCE OF RESERVE AREA B WILL BE THE RESPONSIBILITY OF THE PROPERTY OWNER UNTIL CONVEYANCE TO THE HOMEOWNERS ASSOCIATION. FENCING SHALL MEET THE CITY OF BROKEN ARROW ZONING ORDINANCE REQUIREMENTS FOR ANY PROPOSED FENCING IN THE FLOODPLAIN AREAS.

H. RESERVE AREA C

THE USE OF RESERVE E SHALL BE LIMITED TO OPEN SPACE, RECREATIONS, LANDSCAPING, POOLS, CLUBHOUSES AND UTILITIES. ANY TRAILS CONSTRUCTED WITHIN THE RESERVE MUST MEET ADA REQUIREMENTS AND SHALL BE MAINTAINED BY THE HOMEOWNERS ASSOCIATION. THE RESERVE AREA SHALL SUBSEQUENTLY BE CONVEYED TO THE HOMEOWNERS' ASSOCIATION TO BE FORMED PURSUANT TO SECTION III FOR THE PURPOSES OF THE ADMINISTRATION AND MAINTENANCE OF RESERVES AND OTHER COMMON AREAS OF THE SUBDIVISION.

I. SURFACE DRAINAGE AND LOT GRADING RESTRICTION

EACH LOT SHALL RECEIVE AND DRAIN, IN AN UNOBSTRUCTED MANNER, THE STORM AND SURFACE WATERS FROM LOTS AND DRAINAGE AREAS OF HIGHER ELEVATION AND FROM PUBLIC STREETS AND EASEMENTS. NO LOT OWNER SHALL CONSTRUCT OR PERMIT TO BE CONSTRUCTED ANY FENCING OR OTHER OBSTRUCTIONS WHICH WOULD IMPAIR THE DRAINAGE OF STORM AND SURFACE WATERS OVER AND ACROSS HIS LOT. THE FOREGOING COVENANTS SET FORTH IN THIS PARAGRAPH I SHALL BE ENFORCEABLE BY ANY AFFECTED LOT

OWNER, BY THE OWNER/DEVELOPER AND BY THE HOMEOWNERS ASSOCIATION.

J. LIMITS OF NO ACCESS

THE UNDERSIGNED OWNER/DEVELOPER HEREBY RELINQUISHES RIGHTS OF VEHICULAR INGRESS OR EGRESS FROM ANY PORTION OF THE PROPERTY ADJACENT TO S. 37TH STREET E. WITHIN THE BOUNDS DESIGNATED AS "LIMITS OF NO ACCESS" (L.N.A.) ON THE ACCOMPANYING PLAT, WHICH "LIMITS OF NO ACCESS" MAY BE AMENDED OR RELEASED BY THE CITY OF BROKEN ARROW AREA PLANNING COMMISSION, OR ITS SUCCESSOR, WITH THE APPROVAL OF THE CITY OF BROKEN ARROW, OKLAHOMA, OR AS OTHERWISE PROVIDED BY THE STATUTES AND LAWS OF THE STATE OF OKLAHOMA PERTAINING THERETO, AND THE LIMITS OF NO ACCESS ABOVE ESTABLISHED SHALL BE ENFORCEABLE BY THE CITY OF BROKEN ARROW.

K. SIDEWALKS

SIDEWALKS ARE REQUIRED ALONG STREETS DESIGNATED BY AND IN ACCORDANCE WITH SUBDIVISION REGULATIONS. THE OWNER SHALL CONSTRUCT REQUIRED SIDEWALKS WITHIN ANY RESERVE AREAS, COMMON AREAS AND ALONG ARTERIAL STREET FRONTAGES OF ABUTTING LOTS HAVING ACCESS ONTO MINOR STREETS, AS WELL AS ALL ADA RAMPS. THE DEVELOPER SHALL INSTALL ADA RAMPS AT THE TIME THE STREETS ARE CONSTRUCTED. THE HOMEOWNER WILL NEED TO CONNECT TO RAMP. WHERE SIDEWALKS ARE NOT CONSTRUCTED BY THE OWNER/DEVELOPER, THE BUILDER OF A RESIDENCE ON EACH LOT SHALL CONSTRUCT THE REQUIRED SIDEWALK. REQUIRED SIDEWALKS AND ADA RAMPS SHALL BE CONSTRUCTED IN CONFORMANCE WITH CITY OF BROKEN ARROW ENGINEERING DESIGN STANDARDS.

L. MINIMUM BUILDING SETBACKS AND YARDS

1. NO BUILDING SHALL BE LOCATED NEARER TO THE RIGHT OF WAY OF AN ADJOINING PUBLIC STREET THAN THE BUILDING LINE DEPICTED ON THE ACCOMPANYING PLAT.

2. EACH LOT SHALL MAINTAIN SIDE YARDS WHICH IN THE AGGREGATE ARE NOT LESS THAN TEN (10) FEET IN WIDTH AND NO SIDE YARD SHALL BE LESS THAN FIVE (5) FEET IN WIDTH. SIDE YARDS ABUTTING A STREET SHALL NOT BE LESS THAN FIFTEEN (15) FEET, UNLESS THE GARAGE ENTRY IS LOCATED ON SUCH SIDE, WHERE IT WILL BE NO LESS THAN TWENTY-FIVE (25) FEET.

3. THE MINIMUM REAR YARD SHALL BE TWENTY (20) FEET. CUSTOMARY ACCESSORY STRUCTURES MAY BE LOCATED IN THE REQUIRED REAR YARD, BUT NO BUILDING SHALL BE ERECTED NEARER THAN FIVE (5) FEET TO ANY LOT LINE.

4. NO BUILDING, WHETHER PRINCIPAL OR ACCESSORY, SHALL ENCROACH UPON ANY UTILITY EASEMENT AS DEPICTED ON THE ACCOMPANYING PLAT.

K. CERTIFICATE OF OCCUPANCY RESTRICTIONS

NO CERTIFICATE OF OCCUPANCY SHALL BE ISSUED BY THE CITY OF BROKEN ARROW UNTIL COMPLETION OF THE ENTIRE DEVELOPMENT AND ITS FORMAL ACCEPTANCE BY THE CITY OF BROKEN ARROW. ANY AND ALL CONSTRUCTION PURSUANT TO ANY BUILDING PERMIT, BUT PRIOR TO THE CITY OF BROKEN ARROW'S FORMAL ACCEPTANCE OF THE ENTIRE DEVELOPMENT, SHALL BE AT THE OWNER/DEVELOPER'S, CONTRACTOR'S/BUILDER'S OR INVESTOR'S OWN RISK.

L. FENCE AND LANDSCAPE EASEMENT

THE OWNER HEREBY ESTABLISHES AND RESERVES FOR SUBSEQUENT CONVEYANCE TO THE HOMEOWNER'S ASSOCIATION AN EXCLUSIVE PERPETUAL EASEMENT TO ERECT AND MAINTAIN FENCING, WALLS AND LANDSCAPING ALONG THE WESTERN BOUNDARY OF THE SUBDIVISION WITHIN THE EASEMENTS DEPICTED ON THE ACCOMPANYING PLAT AS "FENCE & LANDSCAPE EASEMENT" OR "F/E". SUCH RIGHTS SHALL BE CONVEYED TO THE HOME OWNERS ASSOCIATION AT A LATER DATE.

M. FENCE PROHIBITION EASEMENT

NO FENCE CONSTRUCTION IS ALLOWED WITHIN THE AREA DESIGNATED ON THE PLAT AS FENCE PROHIBITION EASEMENT. ONG HAS AN EASEMENT RECORDED IN BOOK 2453, PAGE 776 THAT PREDATES THIS PLAT AND REQUIRES THAT NO FENCES BE CONSTRUCTED WITHIN CERTAIN PORTIONS OF THAT EASEMENT TO ENSURE ONG'S USE OF THAT EASEMENT. NO FENCE SHALL BE ERECTED WITHIN THIS EASEMENT FOR ANY PURPOSES. ANY FENCE CONSTRUCTED WITHIN THIS EASEMENT WILL BE REMOVED AT LOT OWNER'S EXPENSE. IN THE EVENT THE LOT OWNER REFUSES TO REMOVE THE FENCE, ONG SHALL HAVE THE EXPLICIT RIGHT TO ENTER ONTO THE PROPERTY AND REMOVE ANY AND ALL FENCE CONTAINED WITHIN A PORTION OF THE FENCE PROHIBITION EASEMENT. THE LOT OWNER SHALL BEAR ALL COSTS ENDURED BY ONG IN THE EFFORT TO REMOVE ANY SUCH PROHIBITED FENCES.

N. OVERLAND DRAINAGE AND DETENTION EASEMENTS

- THE OWNER DOES HEREBY DEDICATE TO THE PUBLIC PERPETUAL EASEMENTS ON, OVER, AND ACROSS THOSE AREAS DESIGNATED ON THE ACCOMPANYING PLAT AS "OVERLAND DRAINAGE EASEMENT" FOR THE PURPOSE OF PERMITTING THE OVERLAND FLOW, CONVEYANCE, AND DISCHARGE OF STORMWATER RUNOFF FROM VARIOUS LOTS WITHIN THE SUBDIVISION AND FROM PROPERTIES OUTSIDE THE SUBDIVISION.
- DRAINAGE FACILITIES LOCATED WITHIN OVERLAND DRAINAGE EASEMENTS SHALL BE CONSTRUCTED IN ACCORDANCE WITH THE ADOPTED STANDARDS OF THE CITY OF BROKEN ARROW, OKLAHOMA, AND PLANS AND SPECIFICATIONS APPROVED BY THE CITY OF BROKEN ARROW, OKLAHOMA.
- NO FENCE, WALL, BUILDING OR OTHER OBSTRUCTION SHALL BE PLACED OR MAINTAINED WITHIN AND OVERLAND DRAINAGE EASEMENT NOR SHALL THERE BE ANY ALTERATION OF THE GRADE IN THE EASEMENTS UNLESS APPROVED BY THE CITY OF BROKEN ARROW, OKLAHOMA, PROVIDED THAT THE PLANTING OF TURF OR CONSTRUCTION OF A WIRE, WROUGHT IRON, SPLIT RAIL, OR SIMILAR APPROVED FENCES SHALL NOT REQUIRE THE APPROVAL OF THE CITY OF BROKEN ARROW, OKLAHOMA. ALL FENCING IN THE ODE MUST BE APPROVED BY THE CITY STORM WATER MANAGER BEFORE INSTALLATION. ANY FENCING IN THE ODE MAY BE REMOVED BY THE CITY AT THE OWNERS EXPENSE AND THE CITY OF BROKEN ARROW IS NOT RESPONSIBLE TO REINSTALL THE FENCING. NO EQUIPMENT SUCH AS HVAC, POOL PUMPS/FILTERS, OR OTHER MECHANICAL EQUIPMENT MAY BE LOCATED IN THE EASEMENT. ANY EQUIPMENT IN THE EASEMENT MAY BE MOVED OR DISCONNECTED AT THE OWNERS EXPENSE AND THE CITY OF BROKEN ARROW IS NOT RESPONSIBLE TO RECONNECT THE EQUIPMENT.
- OVERLAND DRAINAGE EASEMENTS LOCATED WITHIN A LOT SHALL BE MAINTAINED BY THE OWNER OF THE LOT AT THE OWNER'S EXPENSE IN ACCORDANCE WITH STANDARDS PRESCRIBED BY THE CITY OF BROKEN ARROW, OKLAHOMA. IN THE EVENT THE OWNER OF THE LOT FAILS TO PROPERLY MAINTAIN THE EASEMENTS LOCATED THEREON OR, IN THE EVENT OF THE PLACEMENT OF AN OBSTRUCTION WITHIN SUCH EASEMENTS, OR THE ALTERATION OF GRADE THEREIN, THE CITY OF BROKEN ARROW, OKLAHOMA, OR ITS DESIGNATED CONTRACTOR MAY ENTER THE EASEMENTS AND PERFORM MAINTENANCE NECESSARY TO ACHIEVE THE INTENDED DRAINAGE FUNCTIONS AND MAY REMOVE ANY OBSTRUCTION OR CORRECT ANY ALTERATION OF GRADE, AND THE COSTS SHALL BE PAID BY THE LOT OWNER. OBSTRUCTIONS MAY INCLUDE POOL EQUIPMENT OR HVAC EQUIPMENT. IN THE EVENT THE LOT OWNER FAILS TO PAY THE COST OF MAINTENANCE AFTER RECEIPT OF A STATEMENT OF COSTS FROM THE CITY OF BROKEN ARROW, OKLAHOMA, THE CITY MAY FILE OF RECORD A COPY OF THE STATEMENT OF COSTS IN THE LAND RECORDS OF THE WAGONER COUNTY CLERK, AND THEREAFTER THE COSTS SHALL BE A LIEN AGAINST THE LOT. A LIEN ESTABLISHED AS PROVIDED ABOVE MAY BE FORECLOSED BY THE CITY OF BROKEN ARROW, OKLAHOMA.

ADJACENT OWNERSHIP

THE CITY OF BROKEN ARROW HAS A POLICE AND FIRE TRAINING FACILITY TO THE EAST THAT IS USED BOTH DAY AND NIGHT. IN ADDITION, THERE IS A FORMER LANDFILL LOCATED ON THE PROPERTY TO THE EAST. EACH BUILDING PERMIT ISSUED IN THIS SUBDIVISION SHALL INCLUDE A COMMENT REGARDING THE NEARBY POLICE AND FIRE TRAINING FACILITY AND FORMER LANDFILL.

SECTION II. PLANNED UNIT DEVELOPMENT RESTRICTIONS

THE CEDARS AT THE PRESERVE WAS SUBMITTED AS A PLANNED UNIT DEVELOPMENT, DESIGNATED AS PUD 310 PURSUANT TO SECTION 2-Y, ARTICLE A OF THE ZONING ORDINANCE OF THE CITY OF BROKEN ARROW, OKLAHOMA. (ORDINANCE NO. 2931) AS EXISTED ON APRIL 20, 2020 (HEREINAFTER REFERRED TO AS THE "BROKEN ARROW ZONING ORDINANCE"), WHICH P.U.D. NO. 310 WAS RECOMMENDED FOR APPROVAL BY THE PLANNING COMMISSION ON 6/11/2020, AND WAS APPROVED BY THE COUNCIL OF THE CITY OF BROKEN ARROW, OKLAHOMA, ON 6/16/2020. THE PLANNED UNIT DEVELOPMENT PROVISIONS OF THE CITY OF BROKEN ARROW ZONING CODE REQUIRED THE ESTABLISHMENT OF COVENANTS OF RECORD, INJURING TO AND ENFORCEABLE BY THE CITY OF BROKEN ARROW, OKLAHOMA, SUFFICIENT TO ASSURE THE IMPLEMENTATION AND CONTINUING COMPLIANCE WITH THE APPROVED PLANNED UNIT DEVELOPMENT, AND THE OWNER/DEVELOPER DESIRES TO ESTABLISH RESTRICTIONS FOR THE PURPOSE OF PROVIDING FOR AN ORDERLY DEVELOPMENT AND TO INURE ADEQUATE RESTRICTIONS FOR THE MUTUAL BENEFIT OF THE OWNER/DEVELOPER, ITS SUCCESSORS AND ASSIGNS, AND THE CITY OF BROKEN ARROW, OKLAHOMA. THEREFORE, THE OWNER/DEVELOPER DOES HEREBY IMPOSE THE FOLLOWING RESTRICTIONS AND COVENANTS WHICH SHALL BE COVENANTS RUNNING WITH THE LAND AND SHALL BE BINDING UPON THE OWNER/DEVELOPER, ITS SUCCESSORS AND ASSIGNS, AND SHALL BE ENFORCEABLE AS HEREINAFTER SET FORTH. PUD 310 CONSISTS OF 4 DEVELOPMENT AREAS. ONLY DEVELOPMENT AREA B IS LOCATED WITHIN THE CEDARS AT THE PRESERVE I.

DEVELOPMENT STANDARDS (DEVELOPMENT AREA B)

A. IT SHALL BE GOVERNED BY THE BROKEN ARROW ZONING ORDINANCE AND USE AND DIMENSIONAL STANDARDS IN THE CURRENT RS-4 ZONING GUIDELINES EXCEPT AS HEREINAFTER MODIFIED:

1. PERMITTED USES	
SINGLE FAMILY DETACHED DWELLINGS	
2. GROSS RESIDENTIAL AREA	121.22 ACRES
3. MINIMUM GROSS LAND AREA PER DWELLING UNIT: (DU)	10,000 SF
4. MAXIMUM NUMBER OF DWELLING UNITS	540
5. MINIMUM LOT WIDTH	52 FEET
6. MINIMUM LOT SIZE	6,000 SF
7. MINIMUM LIVABILITY SPACE PER LOT	2,800 SF
8. MINIMUM FRONT YARD*	25 FEET
9. MINIMUM SIDE YARD	5 FEET
10. MINIMUM REAR YARD	20 FEET

*ON CORNER LOTS, ONE FRONT YARD SETBACK MAY BE REDUCED TO 15 FEET ALONG THOSE RIGHTS OF WAY THAT HAVE NO VEHICULAR ACCESS. THE JOG IN THE FRONT YARD BETWEEN THE TWO LOTS SHALL NOT EXCEED FIVE FEET.

B. STREET DESIGN AND ACCESS LIMITATIONS

ALL STREET SHALL BE CONSTRUCTED AS REQUIRED TO MEET PUBLIC STREET STANDARDS AS DESCRIBED IN THE CITY OF BROKEN ARROW ENGINEERING STANDARDS. SIDEWALKS SHALL BE CONSTRUCTED BY THE DEVELOPER ALONG 37TH STREET AND ALONG ANY RESERVE AREAS ABUTTING A STREET. NO RESIDENTIAL LOTS SHALL BE ALLOWED TO HAVE DIRECT ACCESS TO 37TH STREET. A SINGLE STUB STREET IS PROPOSED TO THE EAST FOR FUTURE DEVELOPMENT OF THE LAND SOUTH OF THE FORMER LANDFILL SITE AND WEST OF THE CREEK TURNPIKE.

C. UTILITIES

STORM SEWER AND SEWER SERVICE WILL BE PUBLICLY MAINTAINED UTILITIES PROVIDED BY THE CITY OF BROKEN ARROW AND INSTALLED BY THE DEVELOPER. WATER SERVICE WILL BE PROVIDED BY WAGONER COUNTY RURAL WATER DISTRICT NUMBER 4.

D. LANDSCAPE AND SCREENING STANDARDS

LANDSCAPING AND SCREENING WILL BE PROVIDED ALONG 37TH STREET AND SHALL CONFORM TO THE CITY OF BROKEN ARROW ZONING ORDINANCE. A LANDSCAPE AND FENCE EASEMENT OR RESERVE AREA SHALL BE PROVIDED WHERE DEVELOPMENT AREA B ABUTS THE ADJOINING ARTERIAL STREETS AND SHALL CONTAIN THE REQUIRED LANDSCAPING AND SCREENING FOR THE DEVELOPMENT. IN THE EVENT OF RESTRICTIONS REGARDING LANDSCAPING OR FENCING WITHIN EXISTING EASEMENTS ALONG THE PERIMETER OF DEVELOPMENT AREA B REQUIRED PERIMETER FENCING SHALL BE CONTAINED WITHIN A RESERVE OR LANDSCAPE AND FENCE EASEMENT THAT WILL BE MAINTAINED BY THE HOME OWNER'S ASSOCIATION.

Correct the Reference to Paragraph F. This is Paragraph I.

Correct the spelling. "... maintenance OF reserve area"

Correct the Reference to Reserve E. It should be Reserve Area C.

CONDITIONAL FINAL PLAT

The Cedars At The Preserve II

OWNER/DEVELOPER

209TH STREET LLC
1420 W. KENOSHA ST.
BROKEN ARROW, OK 74012
PHONE: 918-258-6161
ATTN: GLENN SHAW

ENGINEER/SURVEYOR

AAB ENGINEERING LLC
CERTIFICATE OF AUTHORIZATION NO. 6318, EXP. JUNE, 30, 2026
PO BOX 2136
SAND SPRINGS, OK 74063
PHONE: 918.514.4283
FAX: 918.514.4288
EMAIL: ALAN @ AABENG.COM

A SUBDIVISION OF THE PART OF THE WEST HALF OF THE NORTHWEST QUARTER (W/2 NW/4) AND PART OF THE NW/4 OF THE SW/4 OF SECTION 32, TOWNSHIP 19 NORTH, RANGE 15 EAST OF THE INDIAN BASE AND MERIDIAN, CITY OF BROKEN ARROW, WAGONER COUNTY, STATE OF OKLAHOMA. PUD-310

SECTION III. PRIVATE RESTRICTIONS

A. ARCHITECTURAL COMMITTEE.

- 1. PLAN REVIEW. NO BUILDING, FENCE, WALL, OR EXTERIOR ANTENNA SHALL BE ERRECTED, PLACED OR ALTERED (INCLUDING EXTERIOR PAINTING) ON ANY LOT UNTIL THE PLANS AND SPECIFICATIONS HAVE BEEN APPROVED IN WRITING BY THE OWNER/DEVELOPER OR ITS AUTHORIZED REPRESENTATIVES OR SUCCESSORS, WHICH ARE HEREINAFTER REFERRED TO AS THE "ARCHITECTURAL COMMITTEE".
2. COMMITTEE PURPOSE. THE ARCHITECTURAL COMMITTEE'S PURPOSE IS TO PROMOTE GOOD DESIGN AND COMPATIBILITY WITHIN THE SUBDIVISION AND IN ITS REVIEW OF PLANS OR DETERMINATION OF ANY WAIVER AS HEREINAFTER AUTHORIZED MAY TAKE INTO CONSIDERATION THE NATURE AND CHARACTER OF THE PROPOSED BUILDING OR STRUCTURE...
3. TRANSFER OF DUTIES. THE POWERS AND DUTIES OF THE ARCHITECTURAL COMMITTEE SHALL, ON LATER OF JANUARY 1, 2030, OR THE TRANSFER OF THE OWNER/DEVELOPER OF ITS LAST LOT IN THE ADDITION BE DEEMED TRANSFERRED TO THE PRESERVE HOMEOWNERS' ASSOCIATION, INC., OWNER/DEVELOPER, OR UPON WRITTEN ASSIGNMENT TO SAID HOMEOWNERS' ASSOCIATION BY THE OWNER/DEVELOPER...

B. USE

THE USE OF THE LOTS SHALL BE LIMITED TO DETACHED SINGLE-FAMILY RESIDENCES AND CUSTOMARY ACCESSORY USES. ONLY ONE RESIDENCE SHALL BE PERMITTED UPON A LOT.

C. FLOOR AREA

- 1. A SINGLE STORY DWELLING SHALL HAVE AT LEAST 1,000 SQUARE FEET OF FINISHED HEATED LIVING AREA.
2. IF A DWELLING HAS TWO LEVELS OR STORIES IMMEDIATELY ABOVE AND BELOW EACH OTHER MEASURED VERTICALLY AND ALL SUCH LEVELS OR STORIES ARE ABOVE THE FINISHED EXTERIOR GRADE OF SUCH DWELLING, THEN SUCH DWELLING SHALL HAVE AT LEAST 1,000 SQUARE FEET OF FINISHED HEATED LIVING AREA ON THE FIRST STORY OR LEVEL AND SHALL HAVE A TOTAL OF THE VARIOUS LEVELS OR STORIES OF AT LEAST 1,400 SQUARE FEET OF FINISHED HEATED LIVING AREA.
3. THE COMPUTATION OF LIVING AREA SHALL NOT INCLUDE ANY BASEMENT, GARAGE, OR ATTIC AREA USED FOR STORAGE. ALL LIVING AREA MEASUREMENTS SHALL BE TAKEN HORIZONTALLY AT THE TOP PLATE LEVEL TO THE FACE OF THE OUTSIDE WALL...
4. THE ARCHITECTURAL COMMITTEE MAY WAIVE, IN THE PARTICULAR INSTANCE, UPON WRITTEN REQUEST, THE FLOOR AREA REQUIREMENTS SET OUT IN PARAGRAPH 1 AND 2 OF THIS SUBSECTION C.

D. MAXIMUM BUILDING HEIGHT

NO BUILDING SHALL EXCEED TWO AND ONE HALF STORIES OR THIRTY- FIVE FEET IN HEIGHT.

E. GARAGES

WITHIN EACH LOT THERE SHALL BE PROVIDED A MINIMUM OF TWO PARKING SPACES WITHIN AN ATTACHED GARAGE. GARAGES SHALL BE ENCLOSED, AND CARPORTS ARE PROHIBITED. GLASS IN GARAGE DOORS IS PROHIBITED.

F. FOUNDATIONS

ANY EXPOSED FOUNDATION SHALL BE BRICK, STONE OR STUCCO. NO STEM WALL SHALL BE EXPOSED.

G. MASONRY

THERE SHALL NOT BE ANY SPECIFIC MASONRY REQUIREMENT OTHER THAN PARAGRAPH F ABOVE.

H. WINDOWS

WITHIN A DWELLING, ALUMINUM WINDOWS HAVING A MILL FINISH ARE PROHIBITED.

I. ROOF PITCH

NO DWELLING SHALL HAVE A ROOF PITCH OF LESS THAN 6/12, EXCEPT FOR PORCHES AND PATIOS THAT IN NO EVENT SHALL HAVE A ROOF PITCH OF LESS THAN 4/12.

J. ROOFING MATERIALS

ROOFING FOR A DWELLING SHALL BE SELF-SEALING COMPOSITION SHINGLES, TAMKO HERITAGE 30 YEAR WEATHERED WOOD IN COLOR. PROVIDED, HOWEVER, THAT IF SUCH ROOFING SHOULD NOT BE REASONABLY AVAILABLE, ALTERNATIVE ROOFING APPROVED BY THE ARCHITECTURAL COMMITTEE SHALL BE PERMITTED UPON DETERMINATION OF THE ARCHITECTURAL COMMITTEE THAT THE ALTERNATIVE IS OF EQUAL OR SUPERIOR QUALITY AND OF A DESIGN AND COLOR COMPATIBLE WITH THE ROOFING MATERIAL ABOVE SPECIFIED.

K. DRIVEWAYS

DRIVEWAYS SHALL BE CONCRETE, SHALL BE THE SAME COLOR AS THE SIDEWALKS AND CURBS WITHIN THE SUBDIVISION, AND SHALL REQUIRE APPROVAL OF THE ARCHITECTURAL COMMITTEE.

L. FENCING

- 1. ALL FENCING SHALL BE IN ACCORDANCE WITH THE CITY OF BROKEN ARROW ZONING CODE. INTERIOR FENCING OR WALLS SHALL NOT EXTEND BEYOND THE BUILDING LINES OF THE LOT AND, IF A DWELLING IS BUILT BEHIND THE FRONT BUILDING LINE OF A LOT, NO FENCE MAY EXTEND BEYOND THE POINT NEAREST THE STREET AT EACH END...
2. WITH RESPECT TO LOTS WHICH ARE CONTIGUOUS WITH LAKES, PONDS OR DETENTION FACILITIES IN RESERVE AREAS, THE SIDE YARD FENCES SHALL BE TAPERED IN HEIGHT TO FIVE FEET (5') WITHIN THIRTY FEET (30') OF THE PERIMETER FENCING THE LAKE, POND OR DETENTION AREA AND WITHIN SAID 30' AREA SHALL BE OF THE SAME SPECIFICATIONS AS THE PERIMETER FENCING DESCRIBED BELOW...

M. SEASONAL DECORATIONS

ALL SEASONAL DECORATIONS SHALL BE REMOVED NO LATER THAN THIRTY (30) CALENDAR DAYS FROM THE DAY OF THE ACTUAL HOLIDAY.

N. ON-SITE CONSTRUCTION

NO RESIDENCE OR BUILDING BUILT OFF-SITE SHALL BE MOVED TO, OR PLACED ON, ANY LOT.

O. OUTBUILDINGS

WITHIN EACH LOT, OUTBUILDINGS ARE PROHIBITED.

P. SWIMMING POOLS

ABOVE GROUND SWIMMING POOLS ARE PROHIBITED.

Q. ANTENNAS

EXTERIOR TELEVISION, "CB" RADIO OR OTHER TYPE ANTENNAS INCLUDING SATELLITE DISHES SHALL BE PROHIBITED, EXCEPT SATELLITE DISHES NOT EXCEEDING 20" IN DIAMETER MAY BE AFFIXED TO A REAR BUILDING WALL OR DORMER IF BELOW THE EAVE, OR GROUND MOUNTED WITHIN A REAR YARD IF NOT EXCEEDING 6' IN HEIGHT, AND IN EACH INSTANCE THE SATELLITE DISH SHALL NOT BE VISIBLE FROM THE STREET VIEW OF THE DWELLING.

R. LOT MAINTENANCE

NO INOPERATIVE VEHICLE OR MACHINERY SHALL BE STORED ON ANY LOT AND EACH LOT SHALL BE MAINTAINED IN A NEAT AND ORDERLY CONDITION FREE OF RUBBISH, TRASH AND OTHER DEBRIS AND SHALL BE CUT, TRIMMED OR MOWED TO PREVENT GROWTH OF WEEDS OR TALL GRASS.

S. RECREATIONAL VEHICLES

BOATS, TRAILERS, CAMPERS AND OTHER RECREATIONAL VEHICULAR EQUIPMENT SHALL NOT BE STORED ON ANY LOT EXCEPT WITHIN AN ENCLOSED GARAGE.

T. NON-RECREATIONAL TRAILERS, MACHINERY AND EQUIPMENT

NO NON-RECREATIONAL TRAILERS, MACHINERY OR EQUIPMENT SHALL BE STORED, PLACED OR PARKED ON ANY LOT, EXCEPT WITHIN AN ENCLOSED GARAGE, OR ON ANY STREET WITHIN THE SUBDIVISION; PROVIDED HOWEVER, NOTHING HEREIN SHALL PROHIBIT THE PARKING OF VEHICLES, MACHINERY AND EQUIPMENT WHEN BEING UTILIZED IN CONNECTION WITH SERVICES PERTAINING TO A RESIDENCE.

U. CLOTHESLINES AND GARBAGE RECEPTACLES

EXPOSED CLOTHESLINE POLES OR OTHER OUTSIDE DRYING APPARATUS ARE PROHIBITED, AND NO EXPOSED GARBAGE CAN, TRASH CAN OR ANY TRASH BURNING APPARATUS OR STRUCTURE SHALL BE PLACED ON ANY LOT OR ANY RESERVE AREA.

V. ANIMALS

NO ANIMALS, LIVESTOCK OR POULTRY OF ANY KIND MAY BE MAINTAINED, BRED, SOLD OR KEPT EXCEPT THAT TWO DOGS, TWO CATS AND OTHER HOUSEHOLD PETS MAY BE KEPT PROVIDED THAT THEY ARE NOT USED FOR COMMERCIAL PURPOSES.

W. NOXIOUS ACTIVITY

NO NOXIOUS OR OFFENSIVE TRADE OR ACTIVITY SHALL BE CARRIED OUT UPON ANY LOT OR UPON ANY RESERVE AREA, NOR SHALL ANYTHING BE DONE THEREON THAT MAY BE OR MAY BECOME AN ANNOYANCE OR NUISANCE TO THE NEIGHBORHOOD.

X. SIGNAGE

NO SIGN OF ANY KIND SHALL BE DISPLAYED TO THE PUBLIC VIEW ON ANY LOT EXCEPT ONE SIGN OF NOT MORE THAN FIVE (5) SQUARE FEET ADVERTISING THE PROPERTY FOR SALE OR RENT. SIGNS USED BY THE OWNER/DEVELOPER OR A BUILDER TO ADVERTISE ANY PROPERTY WITHIN THE ADDITION DURING THE CONSTRUCTION AND LOT SALES PERIOD MAY BE UP TO TWELVE (12) SQUARE FEET. OWNER/DEVELOPER MAY MAINTAIN SIGNAGE AND PROMOTIONAL DISPLAYS FOR AS LONG AS IT OWNS A LOT IN THE ADDITION.

Y. MATERIALS AND STORAGE

NO LOT SHALL BE USED FOR THE STORAGE OF MATERIALS FOR A PERIOD OF GREATER THAN THIRTY (30) DAYS PRIOR TO THE START OF CONSTRUCTION AND THE CONSTRUCTION SHALL BE COMPLETED WITHIN SIX (6) MONTHS THEREAFTER. EACH LOT SHALL BE MAINTAINED IN A NEAT AND ORDERLY CONDITION.

Z. GARAGE SALES/YARD SALES

GARAGE SALES/YARD SALES WILL BE ALLOWED ONCE EACH CALENDAR YEAR. THE DATE WILL BE SET BY THE BOARD OF DIRECTORS OF THE PRESERVE EAST HOMEOWNER'S ASSOCIATION.

AA. TEMPORARY TRASH RECEPTACLES

A TEMPORARY TRASH RECEPTACLE IS REQUIRED ON EACH LOT DURING THE CONSTRUCTION OF ANY DWELLING IN THE SUBDIVISION. THE TEMPORARY TRASH RECEPTACLE SHALL BE MAINTAINED BY THE LOT OWNER AND SHALL BE EMPTIED ON A REGULAR BASIS OR AS NEEDED.

BB. BASKETBALL GOALS

NO BASKETBALL GOAL OR STRUCTURES ARE ALLOWED IN ANY OF THE STREET RIGHTS OF WAY.

SECTION IV. HOMEOWNERS' ASSOCIATION

A. FORMATION OF HOMEOWNERS' ASSOCIATION

THE OWNER/DEVELOPER HAS FORMED AN ASSOCIATION OF THE OWNERS OF THE LOTS WITHIN THE CEDARS AT THE PRESERVE II (HEREINAFTER AND HERETOFORE REFERRED TO AS THE "HOMEOWNERS' ASSOCIATION") TO BE ESTABLISHED IN ACCORDANCE WITH THE STATUTES OF THE STATE OF OKLAHOMA, FOR THE GENERAL PURPOSES OF MAINTAINING THE COMMON AREAS, INCLUDING BUT WITHOUT LIMITATION THE RESERVE AREAS AND PERIMETER FENCING, AND ENHANCING THE VALUE, DESIRABILITY AND ATTRACTIVENESS OF ALL PHASES OF THE PRESERVE.

B. MEMBERSHIP

EVERY PERSON OR ENTITY WHO IS A RECORD OWNER OF THE FEE INTEREST OF A LOT SHALL BE A MEMBER OF THE HOMEOWNERS' ASSOCIATION. MEMBERSHIP SHALL BE APPURTENANT TO AND MAY NOT BE SEPARATED FROM THE OWNERSHIP OF A LOT.

C. ASSESSMENT

EACH RECORD OWNER OF A LOT SHALL BE SUBJECT TO ASSESSMENT BY THE HOMEOWNERS' ASSOCIATION FOR THE PURPOSES OF IMPROVEMENT AND MAINTENANCE OF THE STORM WATER DETENTION FACILITIES, RESERVE AREAS AND OTHER COMMON AREAS.

SECTION V. ENFORCEMENT, DURATION, AMENDMENT AND SEVERABILITY

A. ENFORCEMENT

THE RESTRICTIONS HEREIN SET FORTH ARE COVENANTS TO RUN WITH THE LAND AND SHALL BE BINDING UPON THE OWNER/DEVELOPER, ITS SUCCESSORS AND ASSIGNS. WITHIN THE PROVISIONS OF SECTION I, PUBLIC STREETS, EASEMENTS AND UTILITIES ARE SET FORTH CERTAIN COVENANTS AND THE ENFORCEMENT RIGHTS PERTAINING THERETO, AND ADDITIONALLY THE COVENANTS WITHIN SECTION I, WHETHER OR NOT SPECIFICALLY THEREIN SO STATED SHALL INURE TO THE BENEFIT OF AND SHALL BE ENFORCEABLE BY THE CITY OF BROKEN ARROW, OKLAHOMA. THE COVENANTS CONTAINED IN SECTION III, PRIVATE RESTRICTIONS, AND SECTION IV, HOMEOWNERS' ASSOCIATION, SHALL INURE TO THE BENEFIT OF ANY OWNER OF A LOT AND THE HOMEOWNERS' ASSOCIATION, IF THE OWNER OF ANY LOT SHALL VIOLATE ANY OF THE COVENANTS WITHIN SECTION III, IT SHALL BE LAWFUL FOR ANY OWNER OF A LOT OR THE HOMEOWNERS' ASSOCIATION TO MAINTAIN ANY ACTION AT LAW OR IN EQUITY AGAINST THE PERSON OR PERSONS VIOLATING OR ATTEMPTING TO VIOLATE ANY SUCH COVENANT, TO PREVENT HIM OR THEM FROM SO DOING OR TO COMPEL COMPLIANCE WITH THE COVENANT. IN ANY JUDICIAL ACTION BROUGHT TO ENFORCE THE COVENANTS ESTABLISHED WITHIN THIS DEED OF DEDICATION, THE DEFENSE THAT THE PARTY INITIATING THE EQUITABLE PROCEEDING HAS AN ADEQUATE REMEDY AT LAW IS HEREBY WAIVED. IN ANY JUDICIAL ACTION BROUGHT BY ANY OWNER OF A LOT OR THE ASSOCIATION, WHICH ACTION SEEKS TO ENFORCE THE COVENANTS CONTAINED IN THE RESTRICTIVE COVENANTS HEREIN AND/OR TO RECOVER DAMAGES FOR THE BREACH THEREOF, THE PREVAILING PARTY SHALL BE ENTITLED TO RECEIVE REASONABLE ATTORNEY FEES AND COSTS AND EXPENSES INCURRED IN SUCH ACTION.

B. DURATION

THE RESTRICTIVE COVENANTS HEREIN, TO THE EXTENT PERMITTED BY APPLICABLE LAW, SHALL BE PERPETUAL BUT IN ANY EVENT SHALL BE IN FORCE AND EFFECT FOR A TERM OF NOT LESS THAN THIRTY (30) YEARS FROM THE DATE OF THE RECORDING OF THIS DEED OF DEDICATION UNLESS TERMINATED OR AMENDED AS HEREINAFTER PROVIDED.

C. AMENDMENT

THE COVENANTS CONTAINED WITHIN SECTION I, PUBLIC STREETS, EASEMENTS AND UTILITIES, MAY BE AMENDED OR TERMINATED AT ANY TIME BY A WRITTEN INSTRUMENT SIGNED AND ACKNOWLEDGED BY THE OWNER OF THE LAND TO WHICH THE AMENDMENT OR TERMINATION IS TO BE APPLICABLE AND APPROVED BY THE CITY OF BROKEN ARROW PLANNING COMMISSION, OR ITS SUCCESSORS AND THE CITY OF BROKEN ARROW, OKLAHOMA, THE COVENANTS AND RESTRICTIONS CONTAINED WITHIN SECTION III, PRIVATE RESTRICTIONS, MAY BE AMENDED OR TERMINATED AT ANY TIME BY A WRITTEN INSTRUMENT SIGNED AND ACKNOWLEDGED BY THE OWNER/DEVELOPER DURING SUCH PERIOD THAT THE OWNER/DEVELOPER IS THE OWNER OF AT LEAST 1 LOT, OR ALTERNATIVELY THE COVENANTS AND RESTRICTIONS MAY BE AMENDED OR TERMINATED AT ANY TIME BY A WRITTEN INSTRUMENT SIGNED AND ACKNOWLEDGED BY THE OWNERS OF 60% OF THE LOTS WITHIN THE SUBDIVISION. IN THE EVENT OF ANY CONFLICT BETWEEN AN AMENDMENT OR TERMINATION PROPERLY EXECUTED BY THE OWNER/DEVELOPER (DURING ITS OWNERSHIP OF AT LEAST 1 LOT) AND ANY AMENDMENT OR TERMINATION PROPERLY EXECUTED BY THE OWNERS OF AT LEAST 60% OF THE LOTS, THE INSTRUMENT EXECUTED BY THE OWNER/DEVELOPER SHALL PREVAIL DURING ITS OWNERSHIP OF AT LEAST 1 LOT. THE PROVISIONS CONTAINED WITHIN SECTION IV, HOMEOWNERS' ASSOCIATION, MAY BE AMENDED OR TERMINATED AT ANY TIME BY A WRITTEN INSTRUMENT SIGNED AND ACKNOWLEDGED BY THE OWNER/DEVELOPER DURING SUCH PERIOD THAT THE OWNER/DEVELOPER IS THE OWNER OF AT LEAST 1 LOT, OR ALTERNATIVELY THE COVENANTS AND RESTRICTIONS MAY BE AMENDED OR TERMINATED AT ANY TIME BY A MAJORITY VOTE OF THE MEMBERS OF THE HOMEOWNERS' ASSOCIATION AS EVIDENCED BY WRITTEN INSTRUMENT SIGNED AND ACKNOWLEDGED BY THE PRESIDENT OF THE HOMEOWNERS' ASSOCIATION. IN THE EVENT OF ANY CONFLICT BETWEEN AN AMENDMENT OR TERMINATION PROPERLY EXECUTED BY THE OWNER/DEVELOPER (DURING ITS OWNERSHIP OF AT LEAST 1 LOT) AND ANY AMENDMENT OR TERMINATION EVIDENCED BY AN INSTRUMENT PROPERLY EXECUTED BY THE PRESIDENT OF THE HOMEOWNERS' ASSOCIATION, THE INSTRUMENT EXECUTED BY THE OWNER/DEVELOPER SHALL PREVAIL DURING ITS OWNERSHIP OF AT LEAST 1 LOT. THE PROVISIONS OF ANY INSTRUMENT AMENDING OR TERMINATING COVENANTS AS ABOVE SET FORTH SHALL BE EFFECTIVE FROM AND AFTER THE DATE, IT IS PROPERLY RECORDED.

D. SEVERABILITY

INVALIDATION OF ANY RESTRICTION SET FORTH HEREIN, OR ANY PART THEREOF, BY AN ORDER, JUDGMENT, OR DECREE OF ANY COURT, OR OTHERWISE, SHALL NOT INVALIDATE OR AFFECT ANY OF THE OTHER RESTRICTIONS OR ANY PART THEREOF AS SET FORTH HEREIN, WHICH SHALL REMAIN IN FULL FORCE AND EFFECT.

IN WITNESS WHEREOF: 209TH STREET, LLC, AN OKLAHOMA LIMITED LIABILITY COMPANY, HAS EXECUTED THIS INSTRUMENT THIS ___ DAY OF ___, 2025.

209TH STREET, LLC,
AN OKLAHOMA LIMITED LIABILITY COMPANY

BY: _____
GLENN SHAW, MANAGER

STATE OF OKLAHOMA)
) SS
COUNTY OF WAGONER)

THIS INSTRUMENT WAS ACKNOWLEDGED BEFORE ME ON THIS ___ DAY OF ___, 2025, BY GLENN SHAW, MANAGER OF 209TH STREET, LLC.

NOTARY PUBLIC
MY COMMISSION EXPIRES: _____
COMMISSION NUMBER: _____

WAGONER COUNTY TREASURER'S CERTIFICATE

I, _____, COUNTY TREASURER OF WAGONER COUNTY, OKLAHOMA, HEREBY CERTIFY THAT I HAVE EXAMINED THE RECORDS PERTAINING TO AD VALOREM TAXES ON THE TRACT DESCRIBED IN THE ACCOMPANYING PLAT AND FIND THAT ALL THE AD VALOREM TAXES HAVE BEEN PAID AND INACTED 2024.

DATED THIS ___ DAY OF ___, 2025.

COUNTY TREASURER

CERTIFICATE OF SURVEY

I, MIKEL L. STEWART, A LICENSED PROFESSIONAL LAND SURVEYOR IN THE STATE OF OKLAHOMA, HEREBY CERTIFY THAT I HAVE SURVEYED, SUBDIVIDED AND PLATTED THE ABOVE TRACT DESIGNATED AS "THE CEDARS AT THE PRESERVE II" AN ADDITION TO THE CITY OF BROKEN ARROW, WAGONER COUNTY, STATE OF OKLAHOMA. THE ABOVE PLAT IS AN ACCURATE REPRESENTATION OF SAID SURVEY AND MEETS THE OKLAHOMA MINIMUM STANDARDS FOR THE PRACTICE OF LAND SURVEYING AS ADOPTED BY THE OKLAHOMA STATE BOARD OF LICENSURE FOR PROFESSIONAL ENGINEERS AND LAND SURVEYORS.

MIKEL L. STEWART
LICENSED PROFESSIONAL LAND SURVEYOR
OKLAHOMA NO. 2105

STATE OF OKLAHOMA)
) SS
COUNTY OF WAGONER)

BEFORE ME, A NOTARY PUBLIC IN AND FOR SAID STATE AND COUNTY, ON THIS ___ DAY OF ___, 2025, PERSONALLY APPEARED MIKEL L. STEWART, TO ME KNOWN TO BE THE IDENTICAL PERSON WHO SUBSCRIBED HIS NAME TO THE FOREGOING INSTRUMENT, AND ACKNOWLEDGED TO ME THAT HE EXECUTED THE SAME AS HIS FREE AND VOLUNTARY ACT AND DEED, FOR THE USES AND PURPOSE THEREIN SET FORTH.

NOTARY PUBLIC
MY COMMISSION EXPIRES: NOVEMBER 25, 2027
COMMISSION NUMBER: 19011877

